



DEPARTMENT OF REGULATORY AND ECONOMIC RESOURCES (RER)
BOARD AND CODE ADMINISTRATION DIVISION

NOTICE OF ACCEPTANCE (NOA)

MIAMI-DADE COUNTY
PRODUCT CONTROL SECTION
11805 SW 26 Street, Room 208
Miami, Florida 33175-2474
T (786) 315-2590 F (786) 315-2599
www.miamidade.gov/economy

Nan Ya Plastics Corporation USA
8989 North Loop East, Suite 800
Houston, TX 77029

SCOPE:

This NOA is being issued under the applicable rules and regulations governing the use of construction materials. The documentation submitted has been reviewed and accepted by Miami-Dade County RER -Product Control Section to be used in Miami Dade County and other areas where allowed by the Authority Having Jurisdiction (AHJ).

This NOA shall not be valid after the expiration date stated below. The Miami-Dade County Product Control Section (In Miami Dade County) and/or the AHJ (in areas other than Miami Dade County) reserve the right to have this product or material tested for quality assurance purposes. If this product or material fails to perform in the accepted manner, the manufacturer will incur the expense of such testing and the AHJ may immediately revoke, modify, or suspend the use of such product or material within their jurisdiction. RER reserves the right to revoke this acceptance, if it is determined by Miami-Dade County Product Control Section that this product or material fails to meet the requirements of the applicable building code.

This product is approved as described herein, and has been designed to comply with the Florida Building Code, including the High Velocity Hurricane Zone.

DESCRIPTION: Series "Distinction" Fiberglass Outswing glazed Doors w/wo Sidelites – LMI

APPROVAL DOCUMENT: Drawing No. NAN0011 Rev D, titled "Distinction Double Impact Entry O.S. w/ sidelite", sheets 1 through 10 of 10, dated 04/21/08 and last revised on 02-26-14, prepared by PTC, LLC, signed and sealed by Robert J. Amoroso, P.E., bearing the Miami-Dade County Product Control Revision stamp with the Notice of Acceptance number and expiration date by the Miami-Dade County Product Control Section.

MISSILE IMPACT RATING: Large and Small Missile Impact.

Limitations:

1. Full length wood reinforcements item 17, 18 & 20 at lock-stiles are required.
2. 1x or 2x buck to be properly secured to sustain imposed load and to be reviewed by building Official.

LABELING: Each unit shall bear a permanent label with the manufacturer's name or logo, city, state and series and following statement: "Miami-Dade County Product Control Approved", unless otherwise noted herein.

RENEWAL of this NOA shall be considered after a renewal application has been filed and there has been no change in the applicable building code negatively affecting the performance of this product.

TERMINATION of this NOA will occur after the expiration date or if there has been a revision or change in the materials, use, and/or manufacture of the product or process. Misuse of this NOA as an endorsement of any product, for sales, advertising or any other purposes shall automatically terminate this NOA. Failure to comply with any section of this NOA shall be cause for termination and removal of NOA.

ADVERTISEMENT: The NOA number preceded by the words Miami-Dade County, Florida, and followed by the expiration date may be displayed in advertising literature. If any portion of the NOA is displayed, then it shall be done in its entirety.

INSPECTION: A copy of this entire NOA shall be provided to the user by the manufacturer or its distributors and shall be available for inspection at the job site at the request of the Building Official.

This NOA revises & renews NOA # 12-0612.02 consists of this page 1 and evidence page E-1 and E-2, as well as approval document mentioned above.

The submitted documentation was reviewed by Ishaq I. Chanda, P.E.



NOA No. 14-0305.04
Expiration Date: March 04, 2019
Approval Date: May 22, 2014
Page 1.

NOTICE OF ACCEPTANCE: EVIDENCE SUBMITTED

A. DRAWINGS

1. Manufacturer's die drawings and sections (submitted under file #12-0612.02/ # 08-0425.12).
2. Drawing No. **NAN0011 Rev D**, titled "Distinction Double Impact Entry O.S. w/ sidelite", sheets 1 through 10 of 10, dated 04/21/08 and last revised on 02-26-14, prepared by PTC, LLC, signed and sealed by Robert J. Amoruso, P.E.

B. TESTS (submitted under file #12-0612.02/ # 08-0425.12)

1. Test reports on 1) Air Infiltration Test, per FBC, TAS 202-94
 - 2) Uniform Static Air Pressure Test, Loading per FBC TAS 202-94
 - 3) Water Resistance Test, per FBC, TAS 202-94
 - 4) Large Missile Impact Test per FBC, TAS 201-94
 - 5) Cyclic Wind Pressure Loading per FBC, TAS 203-94
 - 6) Forced Entry Test, per FBC 3603.2 (b) and TAS 202-94

along with marked-up drawings and installation diagram of Fiberglass Outswing glazed Door w/ Sidelites, prepared by ETC Laboratories, Test Report No. **ETC-06-255-174121.4** dated 02/15/08, signed and sealed by Joseph L. Doldan, P.E.

Note: This test report has been revised by an addendum issued by ETC Lab on 08/21/08, signed & sealed by Joseph L. Doldan, P.E.

C. CALCULATIONS


1. Statement letter compliance to FBC 2010 and "No product change", dated February 26, 2014, prepared by PTC, LLC, signed and sealed by Robert J. Amoruso, P.E.
2. Statement letter of compliance to FBC 2007 & 2010 dated April 25, 2012, prepared by PTC, LLC, signed and sealed by Robert J. Amoruso, P.E. (submitted under file #12-0612.03)
3. Anchor verification calculations and structural analysis complying per FBC 2007, prepared by PTC Engineering, Inc., dated 4/21/08, signed and sealed by Douglas J. McDougall, P.E. (submitted under file #08-0425.12)
4. Successor Engineer's letter dated 01/15/09, prepared, signed and sealed by Paul E. Winter, P.E.

D. QUALITY ASSURANCE

1. Miami Dade Department of Regulatory and Economic Resources (RER).

E. MATERIAL CERTIFICATIONS (submitted under file #12-0612.02/ # 08-0425.12)

1. Test report No.ETC-05-255-16776.1, prepared by ETC Laboratories, dated 07/06/06, issued to Nan Ya Plastics Corp., for their SMC Fiberglass material / ETC05033 per ASTM D638-03 "*4500 exposed Xenon Arch*" & tensile strength ASTM D638-03 "*Tensile strength*", Smoke density per ASTM D2843-99, *Rate of burning* per ASTM D635-98 and "*Self ignition*" per ASTM D1929-01, all signed and sealed by Joseph Labora Doldan, P.E.
2. Test report No.ETC-05-255-17144.0, prepared by ETC Laboratories, dated 07/03/08, issued to Nan Ya Plastics Corp., for their Rigid PVC plastic(part #ETC06024) per ASTM D1929-96 "*Standard Test Method for Ignition Properties of Plastics*", ASTM D2843-99 "*Standard Test Method for Density of Smoke from the Burning or Decomposition of Plastics*", ASTM D635-98 "*Standard Test Method for Rate of Burning and/or Extent and Time of Burning of Self-Supporting Plastics in a Horizontal Position*" and ASTM D638-03 "Standard Test Methods for Tensile Properties of Plastics" for exposed & unexposed sample per Xenon Arch after 4500 Hours, signed and sealed by Joseph Labora Doldan, P.E.

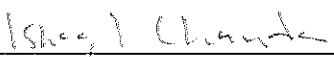

Ishaq I. Chanda, P.E.
Product Control Examiner
NOA No 14-0305.04

Expiration Date: March 04, 2019
Approval Date: May 22, 2014

NOTICE OF ACCEPTANCE: EVIDENCE SUBMITTED

E. MATERIAL CERTIFICATIONS (continue)


4. Test report No.ETC-06-255-17412.0, prepared by ETC Laboratories, dated 04/25/06, issued to Nan Ya Plastics Corp., for their Phenolic Foam Board / ETC06013 plastic per ASTM E84-05 "*Standard Test Method for Surface Burning Characteristics of Building Materials*", signed and sealed by Joseph Labora Doldan, P.E.
5. Test report No.ETC-05-255-17412.1, prepared by ETC Laboratories, dated 04/25/06, re-issued on 06/28/06 to Nan Ya Plastics Corp., for their Phenolic Foam Board / ETC06013 plastic per ASTM E84-05 "*Standard Test Method for Surface Burning Characteristics of Building Materials*", signed and sealed by Joseph L. Doldan, P.E.
6. Test report No.ETC-05-255-17900.0, prepared by ETC Laboratories, dated 06/28/06, issued to Nan Ya Plastics Corp., for their Phenolic Foam Board / ETC06013 plastic per ASTM D1929-96 "*Standard Test Method for Ignition Properties of Plastics*", signed and sealed by Joseph L. Doldan, P.E.
7. Test report No.ETC-05-255-16776.0, prepared by ETC Laboratories, dated 01/04/06, issued to Nan Ya Plastics Corp., for their SMC / ETC05033 plastic per ASTM D1929-96 "*Standard Test Method for Ignition Properties of Plastics*", ASTM D2843-99 "*Standard Test Method for Density of Smoke from the Burning or Decomposition of Plastics*", ASTM D635-98 "*Standard Test Method for Rate of Burning and/or Extent and Time of Burning of Self-Supporting Plastics in a Horizontal Position*" and ASTM D638-03 "*Standard Test Methods for Tensile Properties of Plastics*", signed and sealed by Joseph Labora Doldan, P.E.
8. Test report No.ETC-05-255-16777.1, prepared by ETC Laboratories, dated 07/26/06, issued to Nan Ya Plastics Corp., for their Cellular PVC / ETC05034 plastic per ASTM D1929-96 "*Standard Test Method for Ignition Properties of Plastics*", ASTM D2843-99 "*Standard Test Method for Density of Smoke from the Burning or Decomposition of Plastics*", ASTM D635-98 "*Standard Test Method for Rate of Burning and/or Extent and Time of Burning of Self-Supporting Plastics in a Horizontal Position*" and ASTM D638-03 "*Standard Test Methods for Tensile Properties of Plastics*", signed and sealed by Joseph Labora Doldan, P.E.
9. Notice of Acceptance No. **12-1231.10**, issued to Eastman Chemical Company, (MA) (former Solutia Inc.) for their "**Saflex Clear or color glass interlayer**", expiring on 05/21/16.

F. STATEMENTS

1. Statement letter of compliance to FBC 2010 dated 02/26/2014, prepared by PTC, LLC, signed and sealed by Robert J. Amoruso, P.E.
2. Statement letter of compliance to FBC 2007 & 2010 dated April 25, 2012, prepared by PTC, LLC, signed and sealed by Robert J. Amoruso, P.E. (submitted under file #12-0612.02)
3. Statement letter, dated SEP 04, 2012 of test standard equivalency of plastic material conformance to FBC 2007 & 2010, prepared by PTC, LLC, signed and sealed by Robert J. Amoruso, P.E.
4. Statement letter of conformance to FBC 2007 & no financial interest, issued by PTC, dated April 21, 2008, signed and sealed by Douglas J. McDougall, P.E. (submitted under file #08-0425.12).
5. Certificate of Authority dated May 23, 1983, to transact business, issued to Nan Ya Plastic Corporation, USA issued by the State of Texas, signed by Secretary of State
6. Lab compliance letter as part of above test reports.

G. OTHER

1. This NOA revises & renews NOA # **12-0612.02**, expired on March 04, 2014.
2. Test proposal # **06-1291** dated 11/06/2006 approved by BCCO.

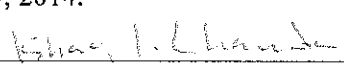
Ishaq I. Chanda, P.E.
Product Control Examiner
NOA No. 14-0305.04
Expiration Date: March 04, 2019
Approval Date: May 22, 2014

NAN YA PLASTICS CORP.
***DISTINCTION IMPACT DOUBLE
ENTRY O.S. DOOR W/ SIDELIGHTS
INSTALLATION ANCHORAGE DETAILS***

GENERAL NOTES:

1. THE PRODUCT ANCHORAGE SHOWN HEREIN IS DESIGNED TO COMPLY WITH THE 2010 FLORIDA BUILDING CODE (FBC), INCLUDING HIGH VELOCITY HURRICANE ZONE (HVHZ) REQUIREMENTS, AT THE DESIGN PRESSURES STATED HEREIN. △
2. THE PRODUCT DETAILS CONTAINED HEREIN ARE BASED UPON SIGNED AND SEALED TEST REPORT #ETC-07-255-18448.3 DATED 12/03/2008, AND ASSOCIATED LABORATORY STAMPED DRAWINGS.
3. THE PRODUCT HAS BEEN EVALUATED FOR CONFORMANCE TO THE STANDARDS LISTED IN THE 2010 FLORIDA BUILDING CODE (FBC) AND IS IN COMPLIANCE WITH SAID STANDARDS, INCLUDING HIGH VELOCITY HURRICANE ZONE (HVHZ) REQUIREMENTS. △
4. ADEQUACY OF THE EXISTING STRUCTURAL CONCRETE / MASONRY AND WOOD FRAMING AS A MAIN WIND FORCE RESISTING SYSTEM CAPABLE OF WITHSTANDING AND TRANSFERRING APPLIED PRODUCT LOADS TO THE FOUNDATION IS THE RESPONSIBILITY OF THE PROJECT ENGINEER OR ARCHITECT OF RECORD.
5. 1X AND 2X BUCKS (WHEN USED) SHALL BE DESIGNED AND ANCHORED TO PROPERLY TRANSFER ALL LOADS TO THE STRUCTURE. BUCK DESIGN AND INSTALLATION IS THE RESPONSIBILITY OF THE PROJECT ENGINEER OR ARCHITECT OF RECORD AND TO BE REVIEWED BY AUTHORITY HAVING JURISDICTION. △
6. THE INSTALLATION DETAILS DESCRIBED HEREIN ARE GENERIC AND MAY NOT REFLECT ACTUAL CONDITIONS FOR A SPECIFIC SITE. IF SITE CONDITIONS CAUSE INSTALLATION TO DEVIATE FROM THE REQUIREMENTS DETAILED HEREIN, THEN THE BUILDING OFFICIAL MAY ELECT ONE OF THE FOLLOWING OPTIONS:

- A. OUTSIDE HVHZ: REQUIRE THAT A LICENSED ENGINEER OR ARCHITECT PREPARE AND SUBMIT SITE SPECIFIC DOCUMENTS FOR USE WITH THIS DOCUMENT TO BE REVIEWED BY AUTHORITY HAVING JURISDICTION. △
- B. INSIDE HVHZ: REQUIRE THAT A ONE-TIME SITE SPECIFIC APPROVAL BE APPLIED FOR AND OBTAINED FROM THE MIAMI-DADE COUNTY PRODUCT CONTROL SECTION. △

7. IN HVHZ AREAS, USE OF AN APPROVED IMPACT PROTECTIVE SYSTEM COMPLYING WITH THE HVHZ REQUIREMENTS OF THE 2010 FBC IS NOT MANDATORY FOR THE PRODUCT HEREIN. △
8. DOOR FRAME AND PANEL FRAME MATERIAL: FOAM PVC DOOR PANEL SKIN IS MOULDED FIBERGLASS SKIN
9. GLASS MEETS THE REQUIREMENTS OF ASTM E1300-04e1 GLASS CHARTS. SEE SHEET 3 AND 4 FOR GLAZING DETAILS.
10. DOOR CONSTRUCTION: FIBERGLASS SKIN W/ PHENOLIC FOAM CORE
11. A 1/3 INCREASE IN ALLOWABLE STRESS FOR WIND LOADS WAS NOT USED IN THE DESIGN OF THE PRODUCT(S) SHOWN HEREIN.
12. ACTIVE DOOR, INACTIVE DOOR AND SIDELITE PANELS CAN BE GLAZED USING GLAZING DETAIL A ON SHEET 3 OR GLAZING DETAIL B ON SHEET 4. △

INSTALLATION NOTES:

1. ONE (1) INSTALLATION ANCHOR IS REQUIRED AT EACH ANCHOR LOCATION SHOWN.
2. THE NUMBER OF INSTALLATION ANCHORS DEPICTED IS THE MINIMUM NUMBER OF ANCHORS TO BE USED FOR PRODUCT INSTALLATION.
3. SHIM AS REQUIRED AT EACH INSTALLATION ANCHOR WITH LOAD BEARING SHIM. MAXIMUM ALLOWABLE SHIM SIZE OF 1/4 INCH. SHIM WHERE SPACE OF 1/16 INCH OR GREATER OCCURS. SHIM SHALL BE CONSTRUCTED OF HIGH DENSITY PLASTIC OR BETTER.
4. FOR INSTALLATION INTO WOOD FRAMING, USE #12 WOOD SCREWS OF SUFFICIENT LENGTH TO ACHIEVE 1 1/2 INCH MINIMUM EMBEDMENT.
5. FOR INSTALLATION THROUGH 1X BUCK (BUCK TO BE PROPERLY SECURED) TO CONCRETE / MASONRY, OR DIRECTLY INTO CONCRETE / MASONRY, USE 1/4 INCH ITW TAPCONS OF SUFFICIENT LENGTH TO ACHIEVE 1 1/4 INCH MINIMUM EMBEDMENT. △
6. MINIMUM EMBEDMENT AND EDGE DISTANCE EXCLUDE WALL FINISHES (INCLUDING BUT NOT LIMITED TO STUCCO, FOAM, BRICK VENEER, AND SIDING).

7. INSTALLATION ANCHORS AND ASSOCIATED HARDWARE MUST BE MADE OF CORROSION RESISTANT MATERIAL OR HAVE A CORROSION RESISTANT COATING.
8. FOR CONCRETE BLOCK, DO NOT INSTALL INSTALLATION ANCHORS INTO MORTAR JOINTS. EDGE DISTANCE IS MEASURED FROM FREE EDGE OF BLOCK OR EDGE OF MORTAR JOINT INTO FACE SHELL OF BLOCK.
9. INSTALLATION ANCHORS SHALL BE INSTALLED IN ACCORDANCE WITH ANCHOR MANUFACTURER'S INSTALLATION INSTRUCTIONS, AND ANCHORS SHALL NOT BE USED IN SUBSTRATES WITH STRENGTHS LESS THAN THE MINIMUM STRENGTH SPECIFIED BY THE ANCHOR MANUFACTURER.
10. INSTALLATION ANCHOR CAPACITIES FOR PRODUCTS HEREIN ARE BASED ON SUBSTRATE MATERIALS WITH THE FOLLOWING PROPERTIES:
- A. WOOD - PT SOUTHERN YELLOW PINE, MINIMUM SPECIFIC GRAVITY OF 0.55.
- B. CONCRETE - MINIMUM COMPRESSIVE STRENGTH OF 3192 PSI AND COMPLIES WITH ACI 301.
- C. MASONRY - STRENGTH CONFORMANCE TO ASTM C-90.

TABLE OF CONTENTS	
SHEET	SHEET DESCRIPTION
1	GENERAL AND INSTALLATION NOTES
2	ELEVATION AND ANCHOR LAYOUT
3	VERTICAL SECTIONS AND GLAZING DETAIL
4	VERTICAL SECTIONS AND GLAZING DETAIL
5	VERTICAL SECTIONS
6	VERTICAL SECTIONS
7	HORIZONTAL SECTIONS
8	HORIZONTAL SECTIONS
9	BILL OF MATERIALS
10	COMPONENTS

DESIGN PRESSURE RATING (PSF)		IMPACT RATING
WATER INFILTRATION REQUIRED	WATER INFILTRATION NOT REQUIRED	
±50.0	±50.0	LARGE MISSILE IMPACT

PRODUCT REVISED
to comply with the Florida
Building Code
Acceptance No. 14-0305-04
Expiration Date MAR 04, 2019
By Ishag L. Chaudhry
Miami Dade Product Control

PROJECT NO. 414-0107

D

NOA RENEWAL

02/26/14

RJA

C

UPDATE TO 2010 FBC

04/25/12

TJH

B

PER MIAMI DADE

01/06/09

SMC

REV

DESCRIPTION

DATE

BY

NAN YA PLASTICS CORP.

8989 NORTH LOOP EAST

HOUSTON, TX 77029

DISTINCTION DOUBLE IMPACT ENTRY O.S. DOOR W/ SIDELITES

GENERAL AND ANCHOR NOTES

PREPARED BY:

DATE: 04/21/08

DRAWING NO: NAN0011

SCALE: N.T.S.

REV: D

SHEET: 1 OF 10

PTC PRODUCT DESIGN GROUP, LLC

PO BOX 520775

LONGWOOD, FLORIDA 32752

PHONE: 321.890.1788

FAX: 321.890.1789


EMAIL: info@ptc-corp.com

Robert J. Amoroso, P.E.


FL P.E. No. 49752

4/19/14


2/26/14

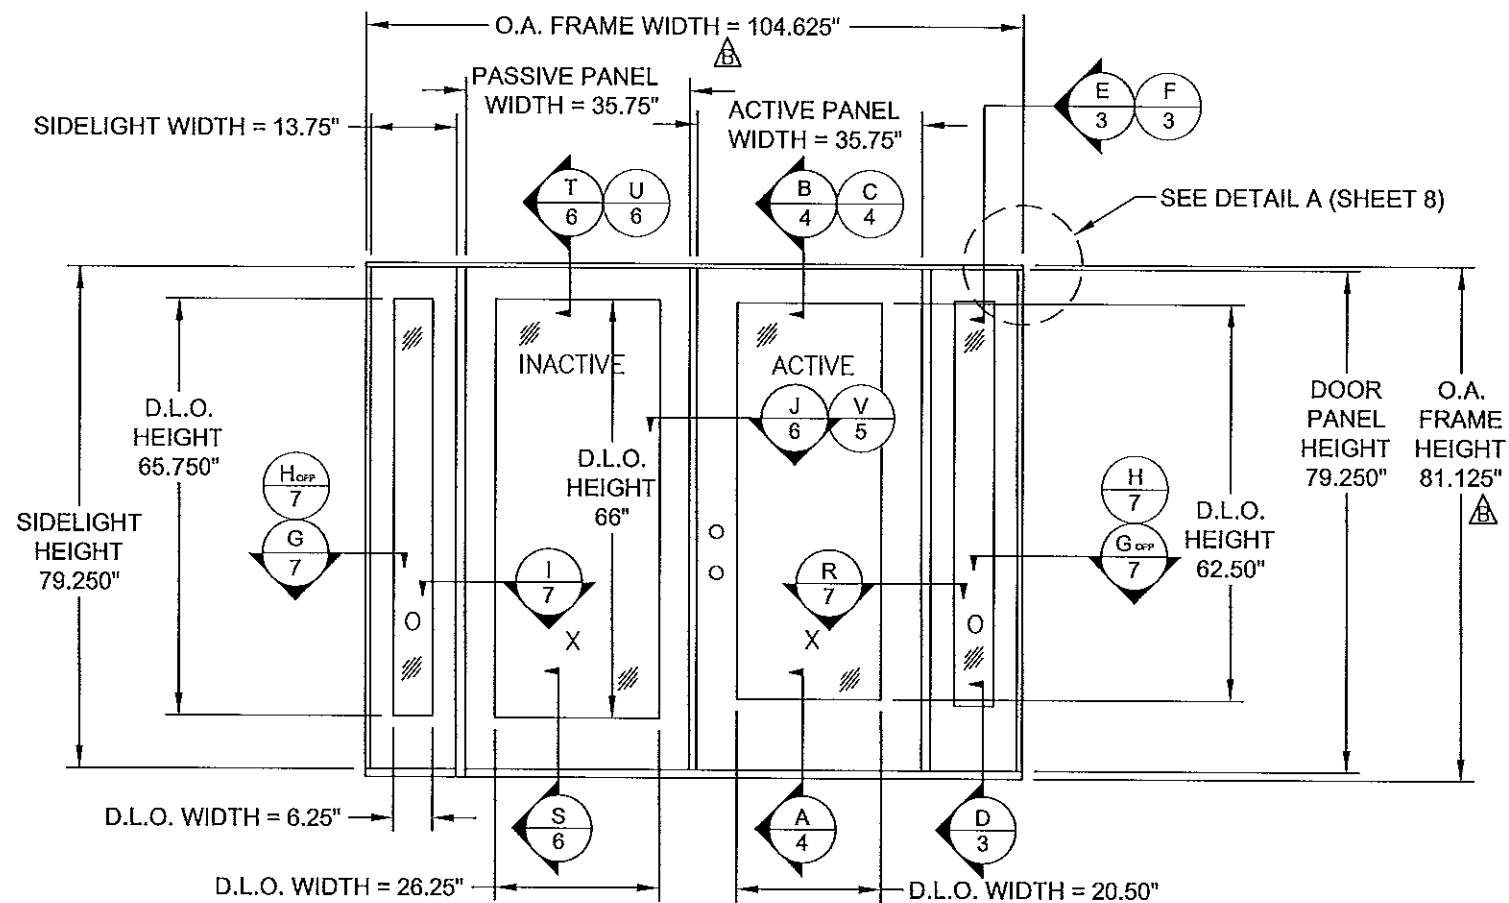

ELEVATION

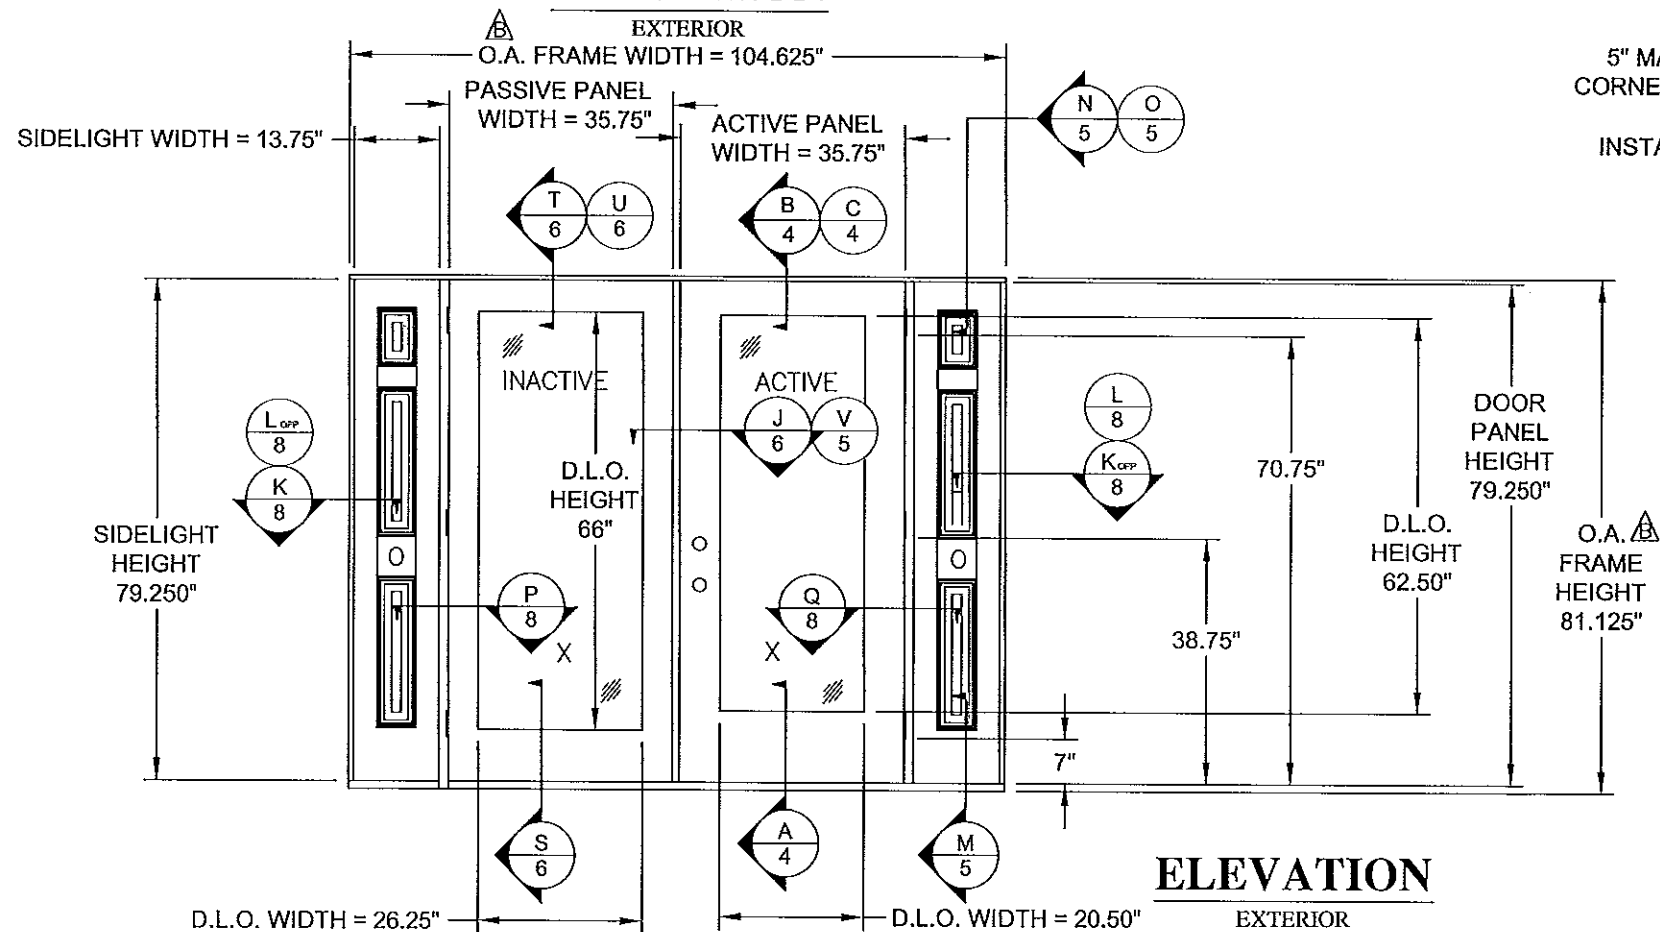

ELEVATION

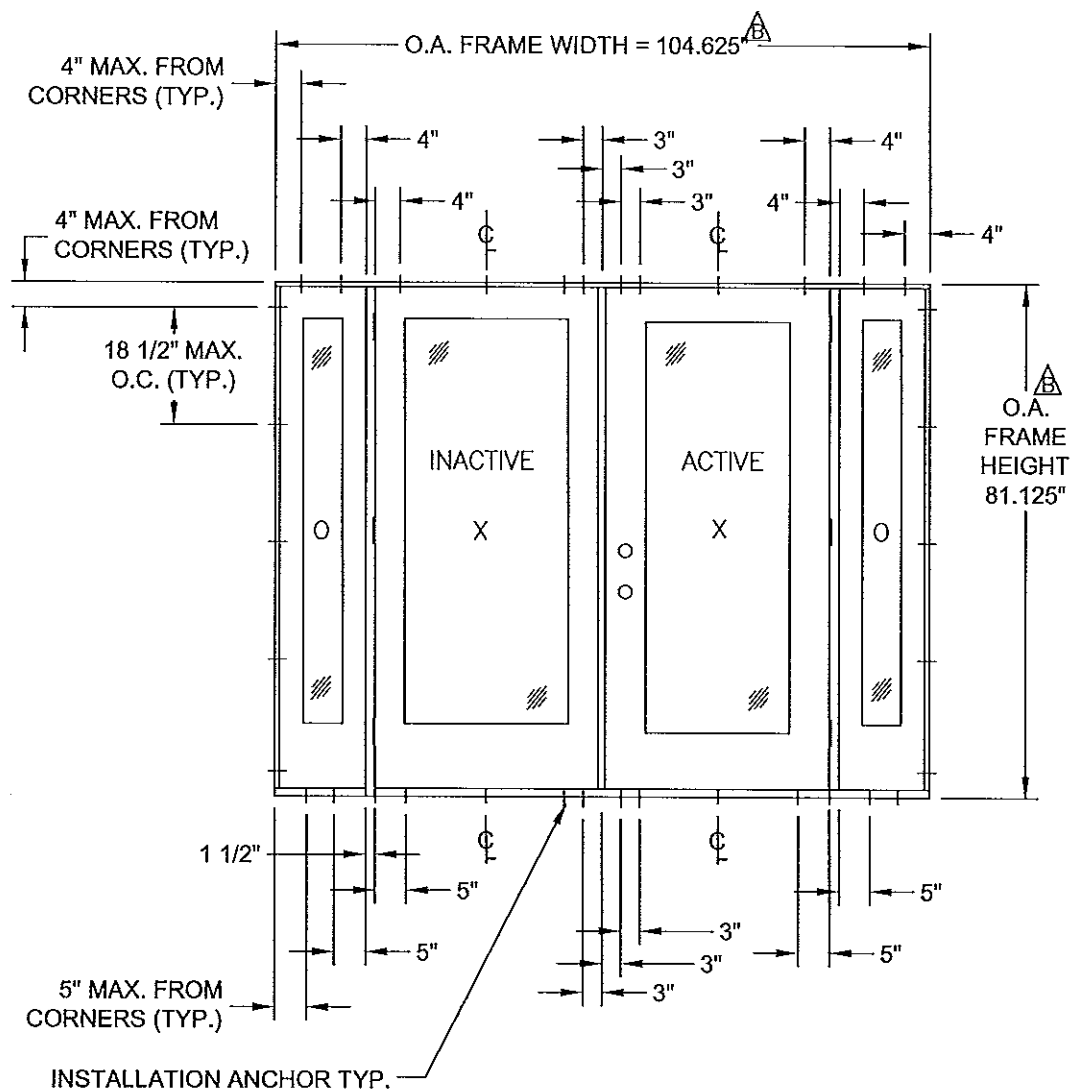

ANCHOR LAYOUT

EXTERIOR
TYPICAL GLAZED OR OPAQUE SIDELITES


PRODUCT REVISED
to comply with the Florida
Building Code
Acceptance No. 14-030504
Expiration Date 3/27/2019
By [Signature]
Miami Dade Product Control

PROJECT NO. 414-0107	NOA RENEWAL	NOA RENEWAL	NOA RENEWAL	NOA RENEWAL
02/26/14	02/26/14	02/26/14	02/26/14	02/26/14
RJA	RJA	RJA	RJA	RJA
DATE	DATE	DATE	DATE	DATE
1/15/09	1/15/09	1/15/09	1/15/09	1/15/09
SMC	SMC	SMC	SMC	SMC
REV	REV	REV	REV	REV
DESCRIPTION	DESCRIPTION	DESCRIPTION	DESCRIPTION	DESCRIPTION
PER MIAMI DADE	PER MIAMI DADE	PER MIAMI DADE	PER MIAMI DADE	PER MIAMI DADE
01/06/09	01/06/09	01/06/09	01/06/09	01/06/09
DATE	DATE	DATE	DATE	DATE
BY	BY	BY	BY	BY


NAN YA PLASTICS CORP.	DATE:	04/21/08
8989 NORTH LOOP EAST	DRAWING NO:	NAN0011
HOUSTON, TX 77029	SCALE:	N.T.S.
DISTINCTION DOUBLE IMPACT ENTRY O.S. DOOR W/ SIDELITES	REV:	D
ELEVATION AND ANCHOR LAYOUT	SHEET:	2 OF 10
PREPARED BY:	DATE:	04/21/08
PTC PRODUCT DESIGN GROUP, LLC	DRAWING NO:	NAN0011
PO BOX 50775	SCALE:	N.T.S.
LONGWOOD, FLORIDA 32752	REV:	D
Phone: 321.660.1788	SHEET:	2 OF 10
Fax: 321.660.1789	DATE:	04/21/08
Email: info@ptc-corp.com	DRAWING NO:	NAN0011

Robert J. Amoroso, P.E.
FL P.E. No. 49752


11/10/14
[Signature]

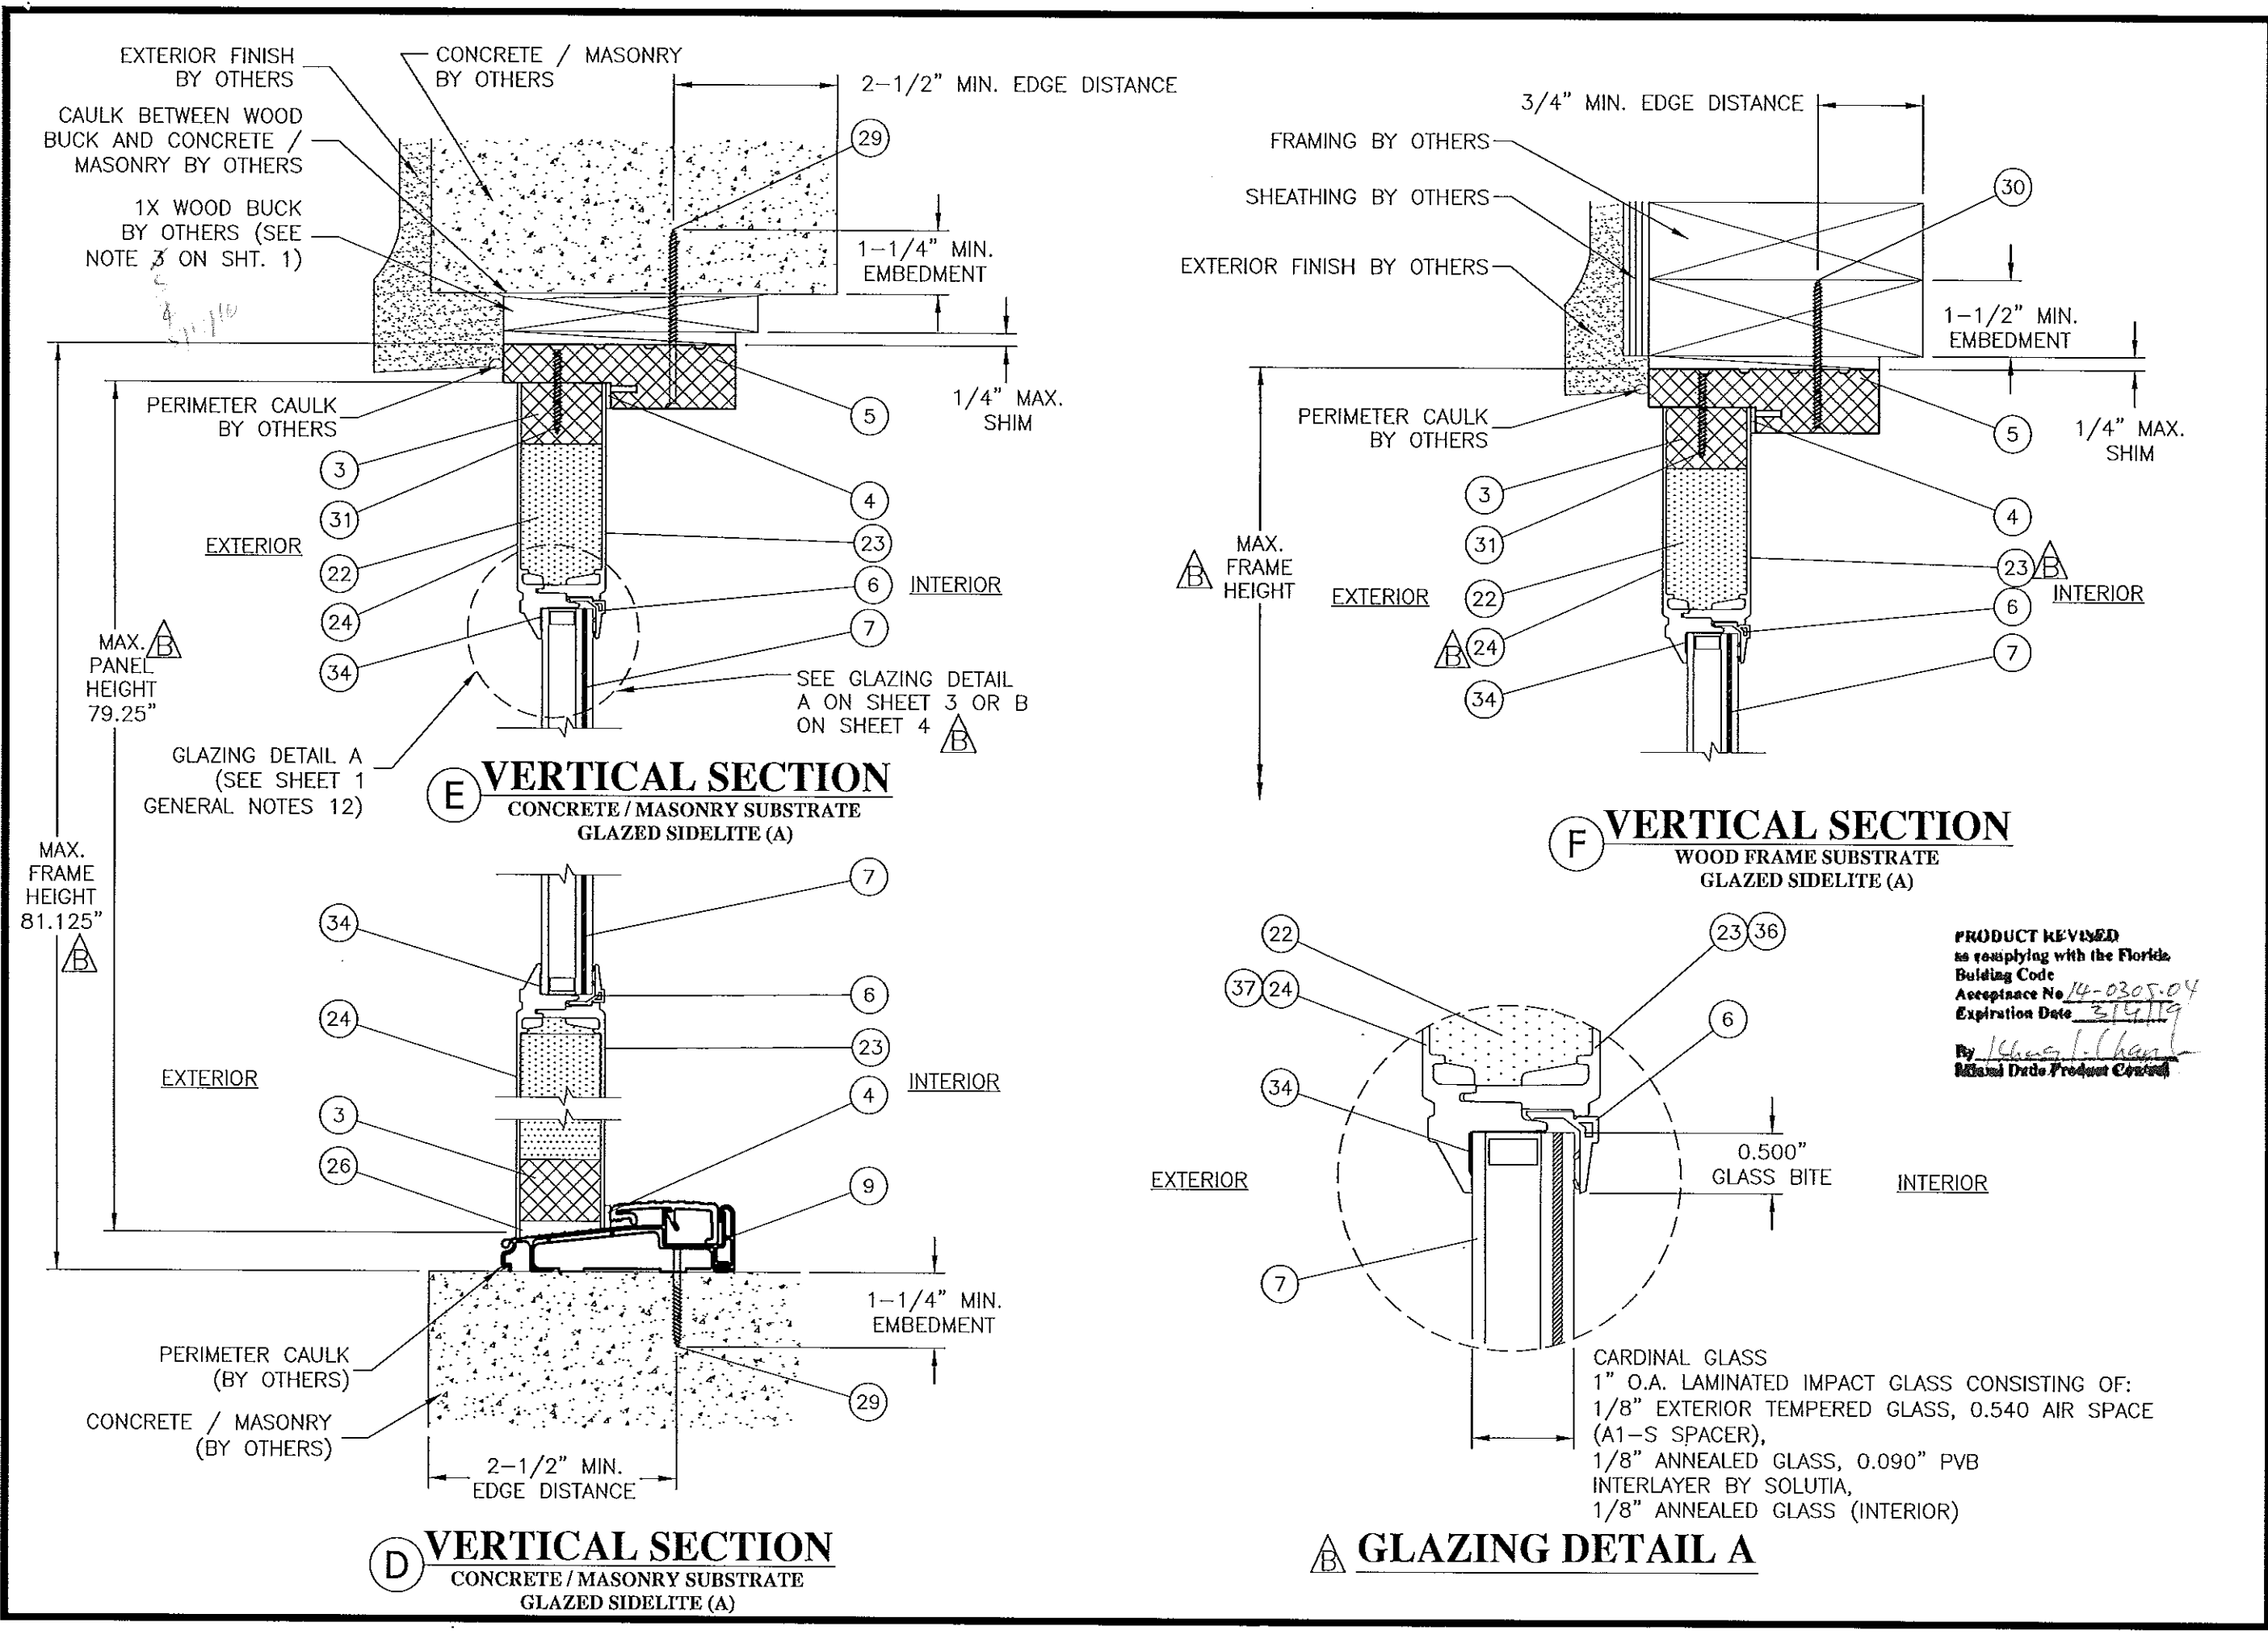


PROJECT NO. 414-0107		NOA RENEWAL		UPDATE TO 2010 FBC		PER MIAMI DADE		REV	
RJA		02/26/14		TJH		1/15/09		DATE	
D		C		B		REV		DESCRIPTION	
DISTINCTION DOUBLE IMPACT ENTRY O.S. DOOR W/ SIDELITES		VERTICAL SECTIONS AND GLAZING DETAIL		DRAWN BY: 04/21/08		SCALE: N.T.S.		SHEET: 3 OF 10	
NAN YA PLASTICS CORP.		8989 NORTH LOOP EAST		HOUSTON, TX 77029		DRAWING NO: NAN0011		REV: D	
PREPARED BY:		DATE: 04/21/08		SCALE: N.T.S.		DRAWING NO: NAN0011		SHEET: 3 OF 10	
PTG PRODUCT DESIGN GROUP, LLC		PO BOX 520775		LONGWOOD, FLORIDA 32752		Phone: 321.662.1788		Fax: 321.662.1788	
Robert J. Amoroso, P.E.		FL P.E. No. 49752		By: [Signature]		Product Control		[Signature]	

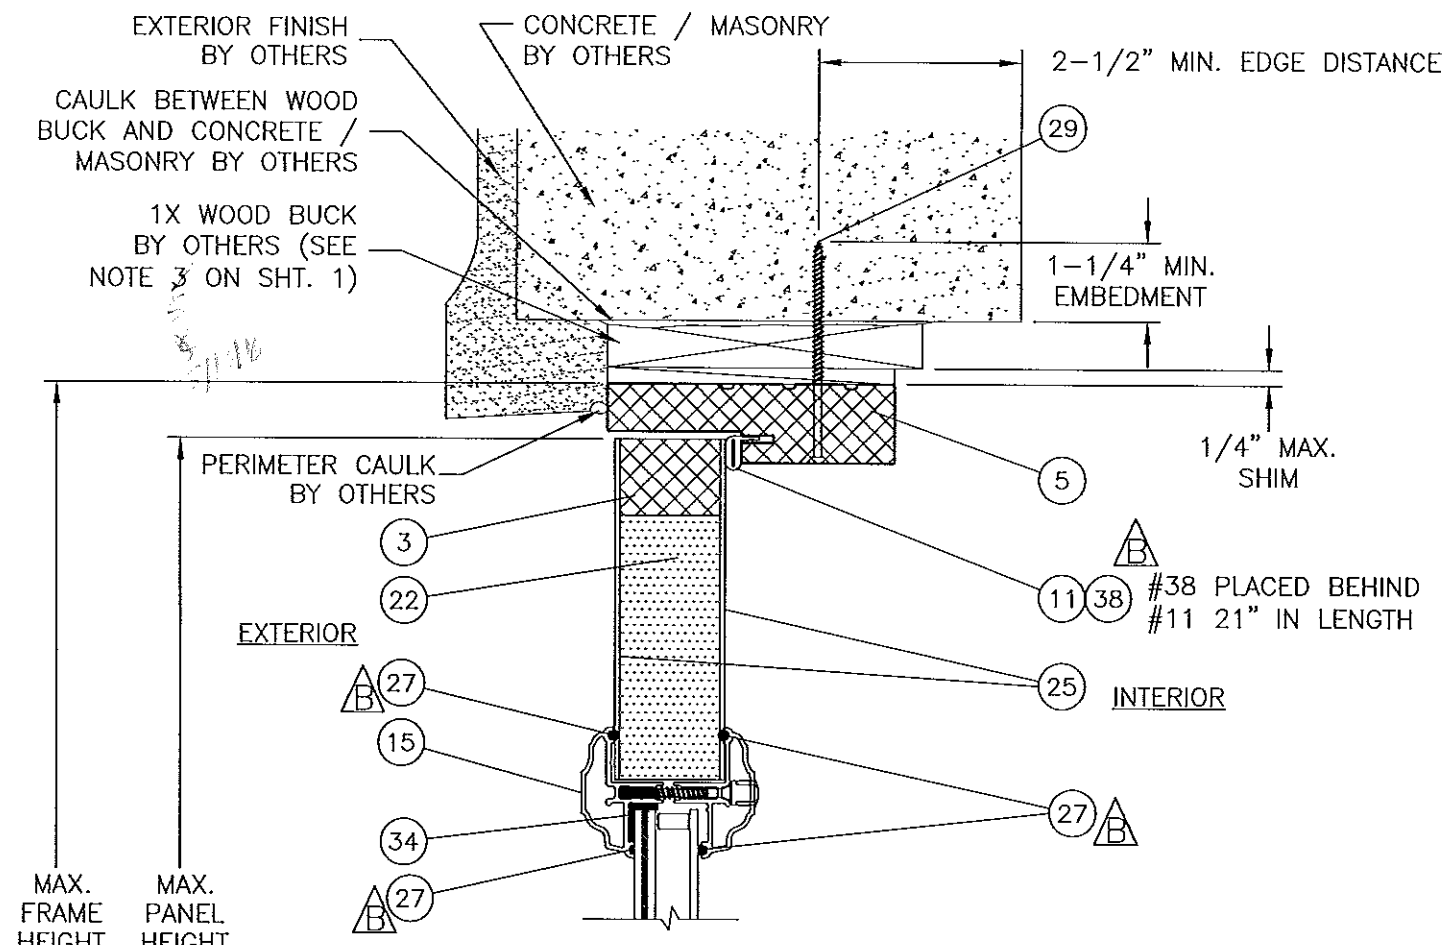


VERTICAL SECTION
CONCRETE / MASONRY SUBSTRATE
DOOR PANEL (B)

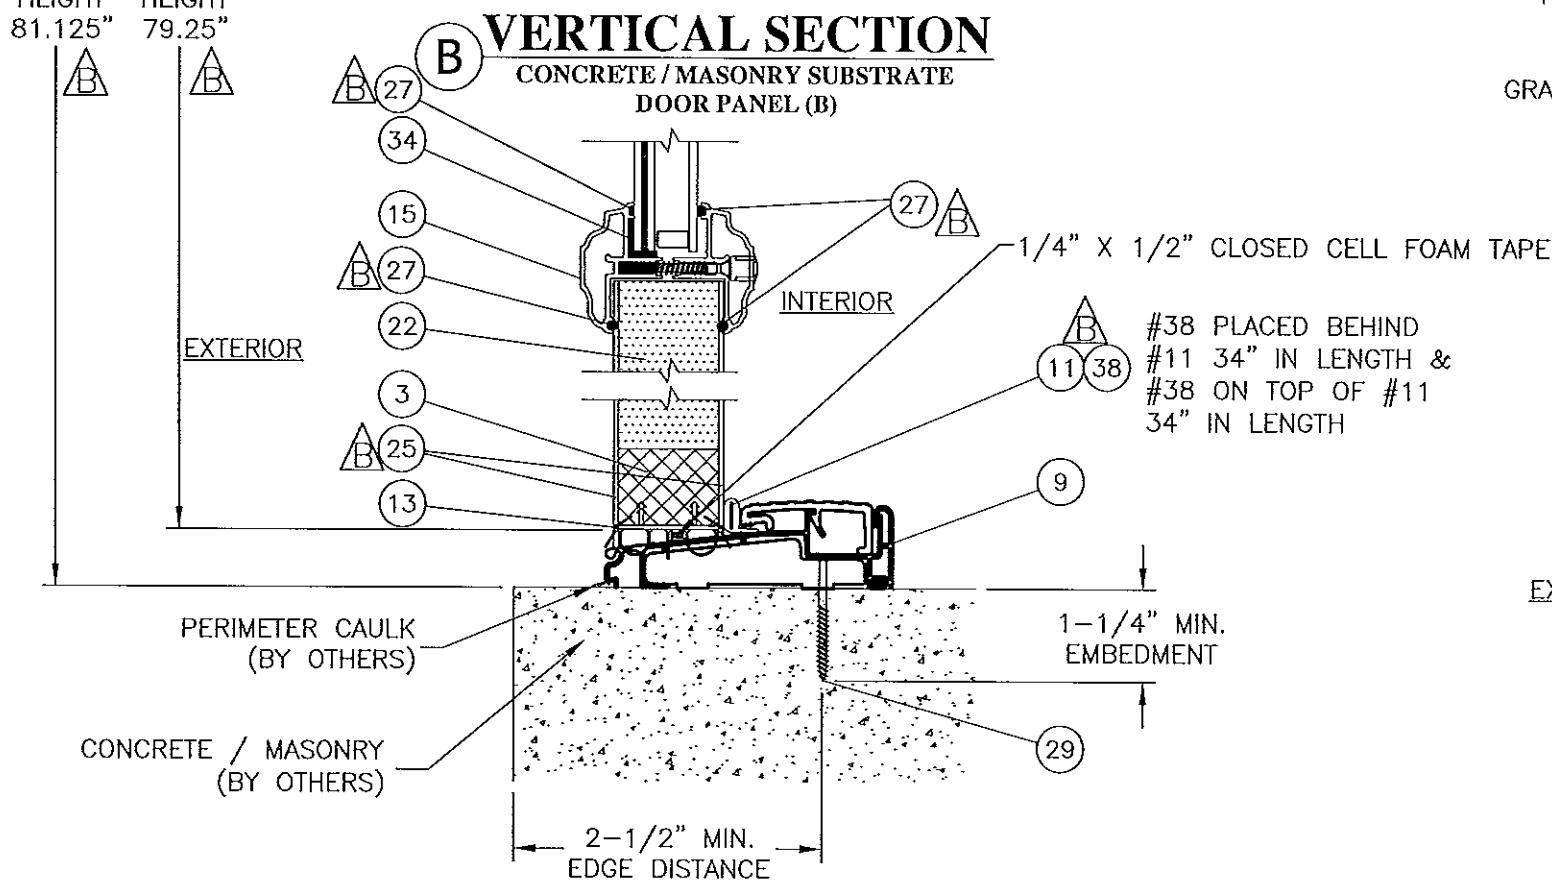

VERTICAL SECTION
CONCRETE / MASONRY SUBSTRATE
DOOR PANEL (B)

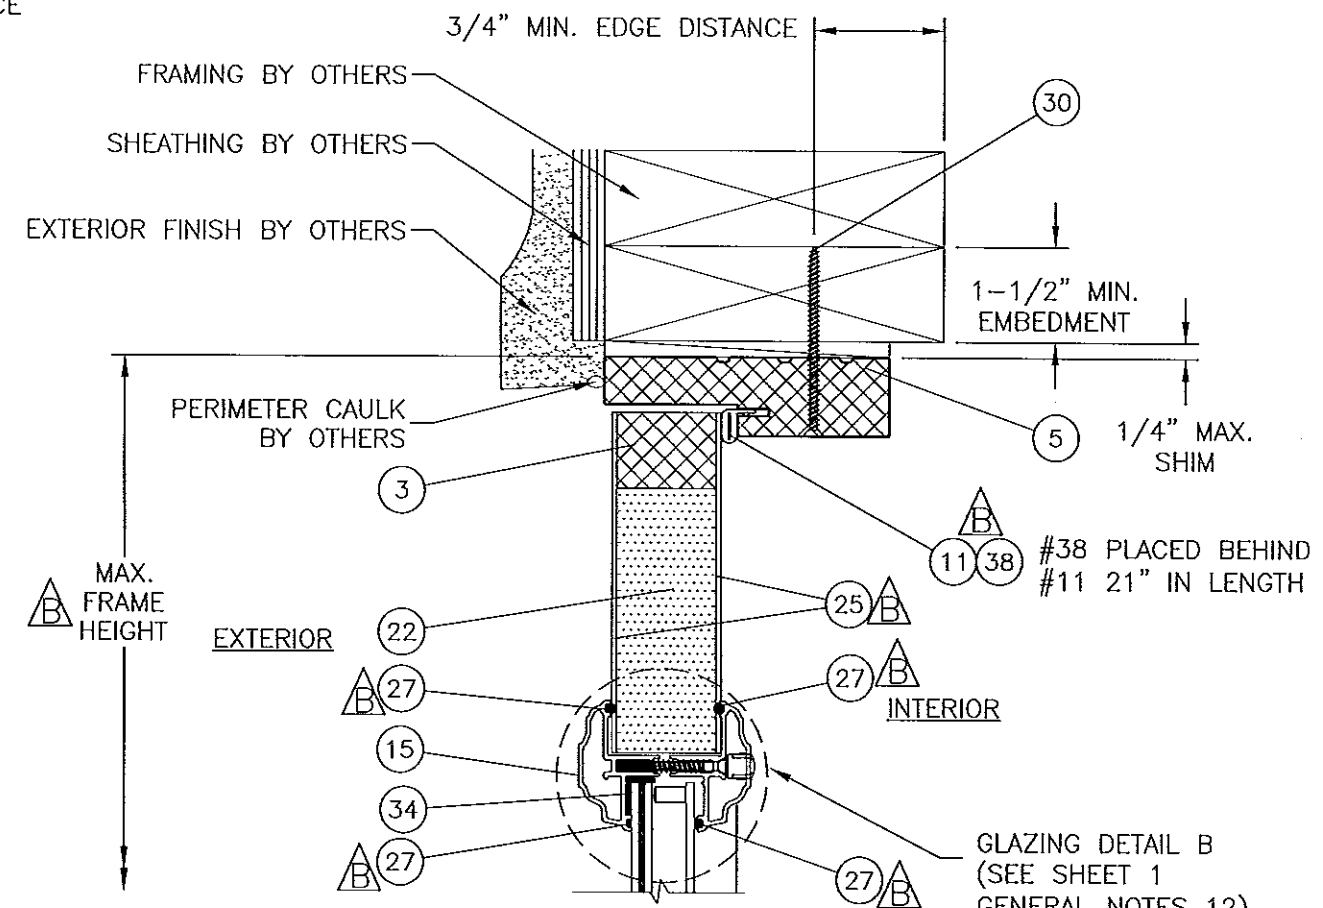

VERTICAL SECTION
WOOD FRAME SUBSTRATE
DOOR PANEL (B)

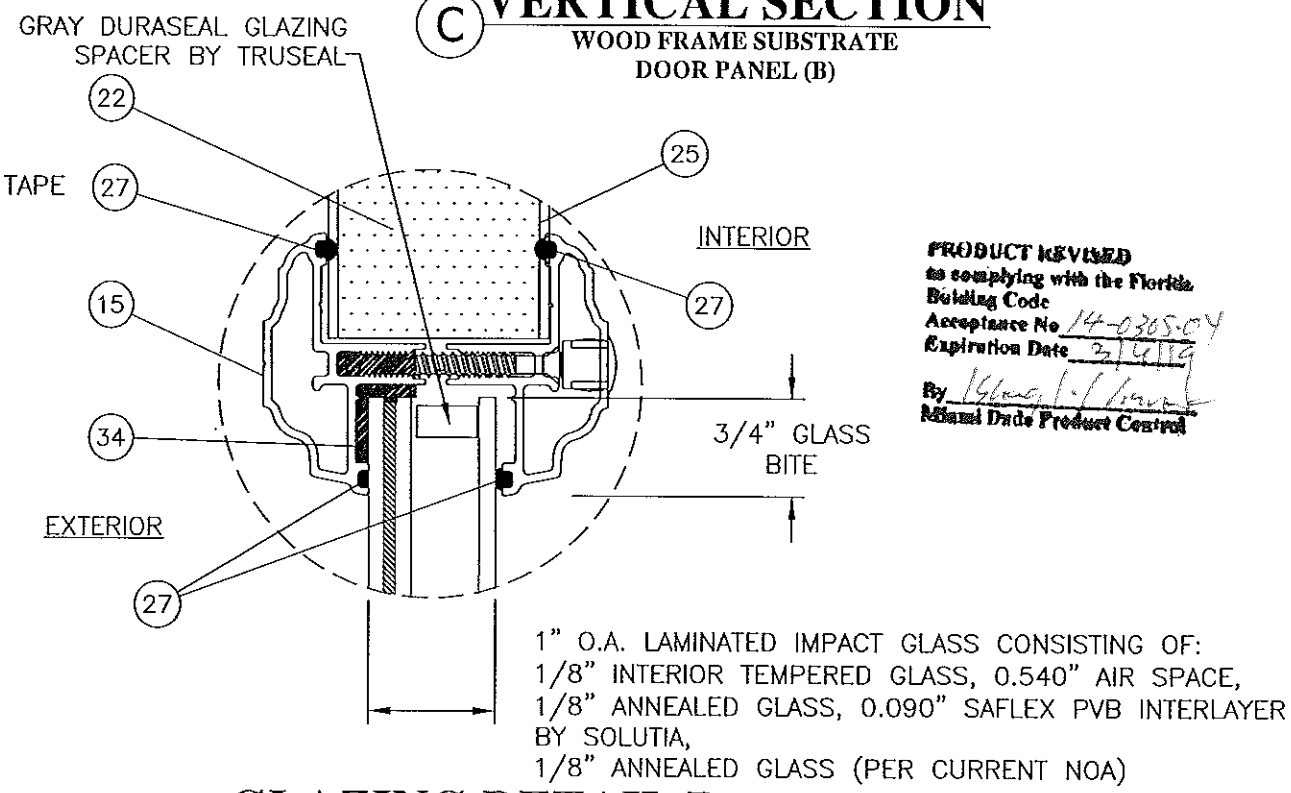


GLAZING DETAIL B
ODL LITE KIT (PER CURRENT NOA)

PRODUCT REVISED
to comply with the Florida
Building Code
Acceptance No. 14-0305-04
Expiration Date 3/1/19
By 16/06/19
Miami Dade Product Control


PROJECT NO. 414-0107	RJA	02/26/14	TJH	SMC	BY
NOA RENEWAL	UPDATE TO 2010 FBC	PER MIAMI DADE	01/06/09	DESCRIPTION	DATE
D	C	B	REV		

NAN YA PLASTICS CORP. 8989 NORTH LOOP EAST HOUSTON, TX 77029	DATE: 04/21/08	DRAWING NO: NAN0011	SHEET: 4 OF 10
PREPARED BY: DISTINCTION DOUBLE IMPACT ENTRY O.S. DOOR W/ SIDELITES VERTICAL SECTIONS AND GLAZING DETAIL	SCALE: N.T.S.	REV: D	
PTC PRODUCT DESIGN GROUP, LLC PO BOX 520775 LONGWOOD, FLORIDA 32752 Phone: 321.660.1788 Fax: 321.660.1789 Email: info@ptc-corp.com			


Robert J. Amoroso, P.E.
FL P.E. No. 49752
11/19/12

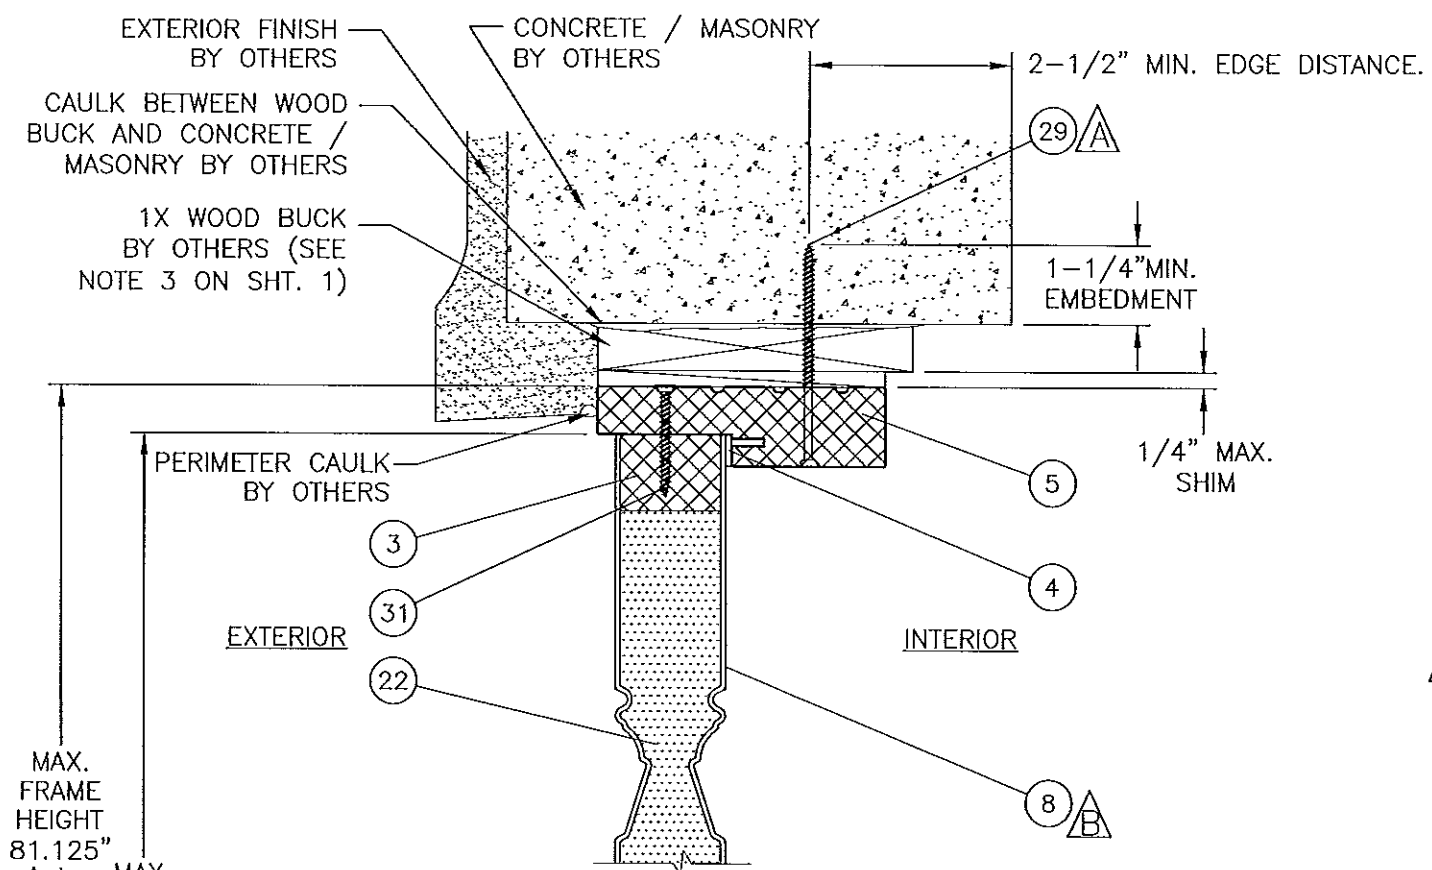


VERTICAL SECTION
CONCRETE / MASONRY SUBSTRATE
OPAQUE SIDELITE

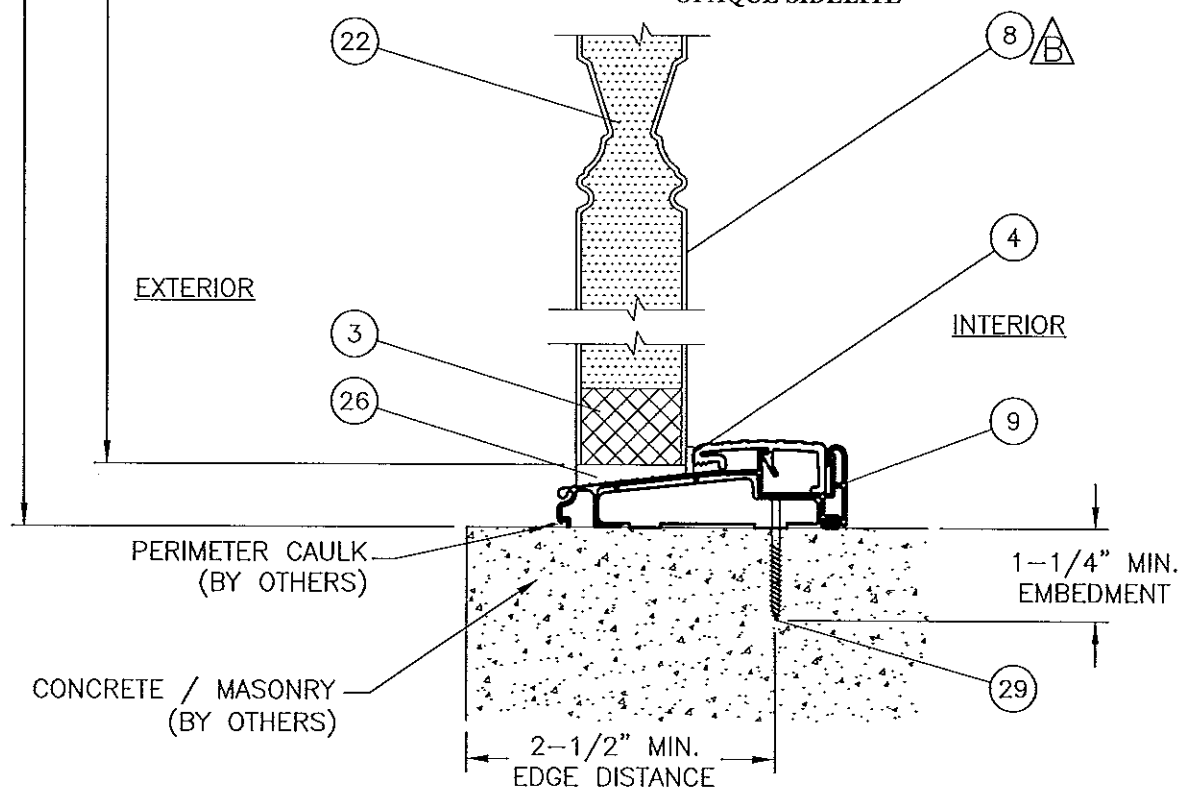

VERTICAL SECTION
CONCRETE / MASONRY SUBSTRATE
OPAQUE SIDELITE

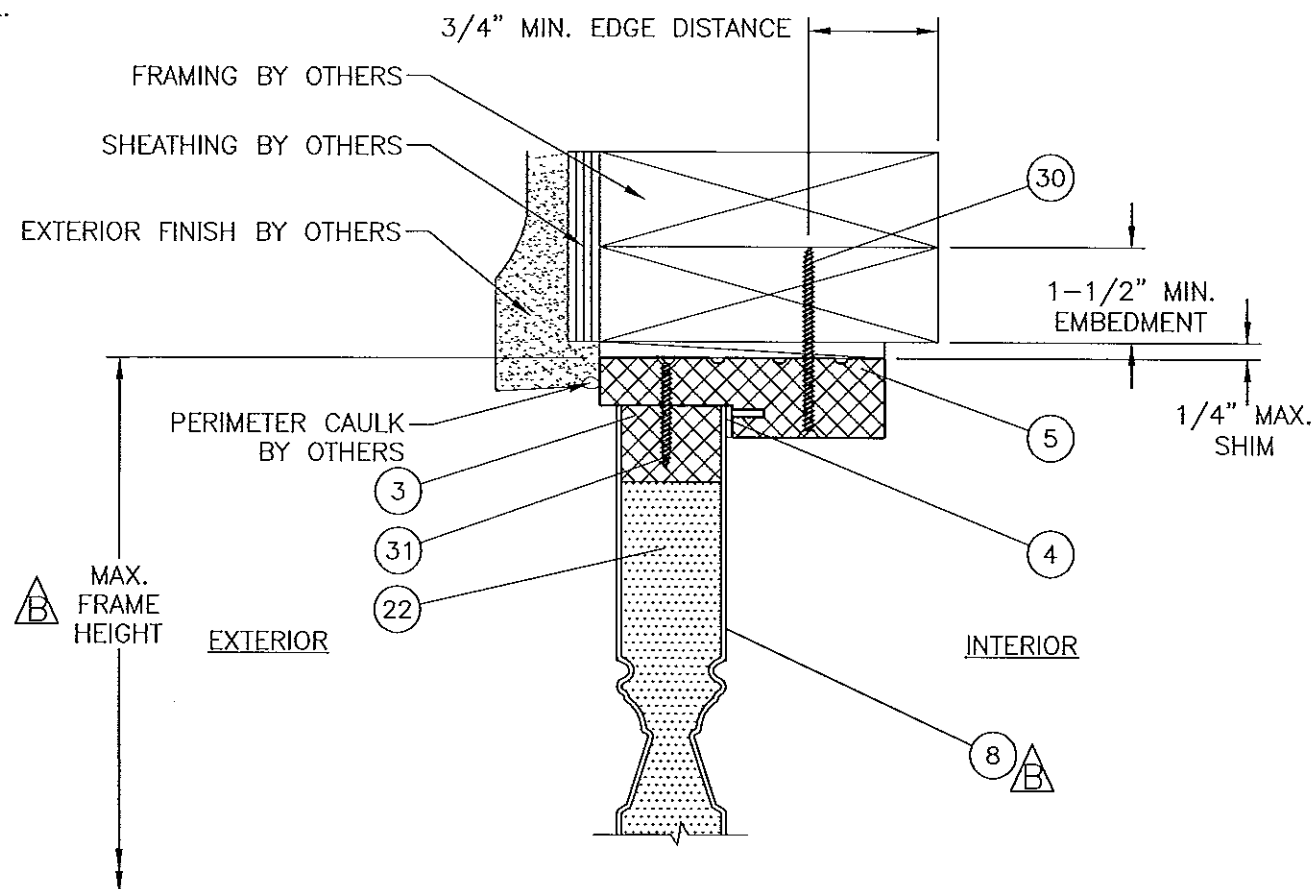

VERTICAL SECTION
WOOD FRAME SUBSTRATE
OPAQUE SIDELITE

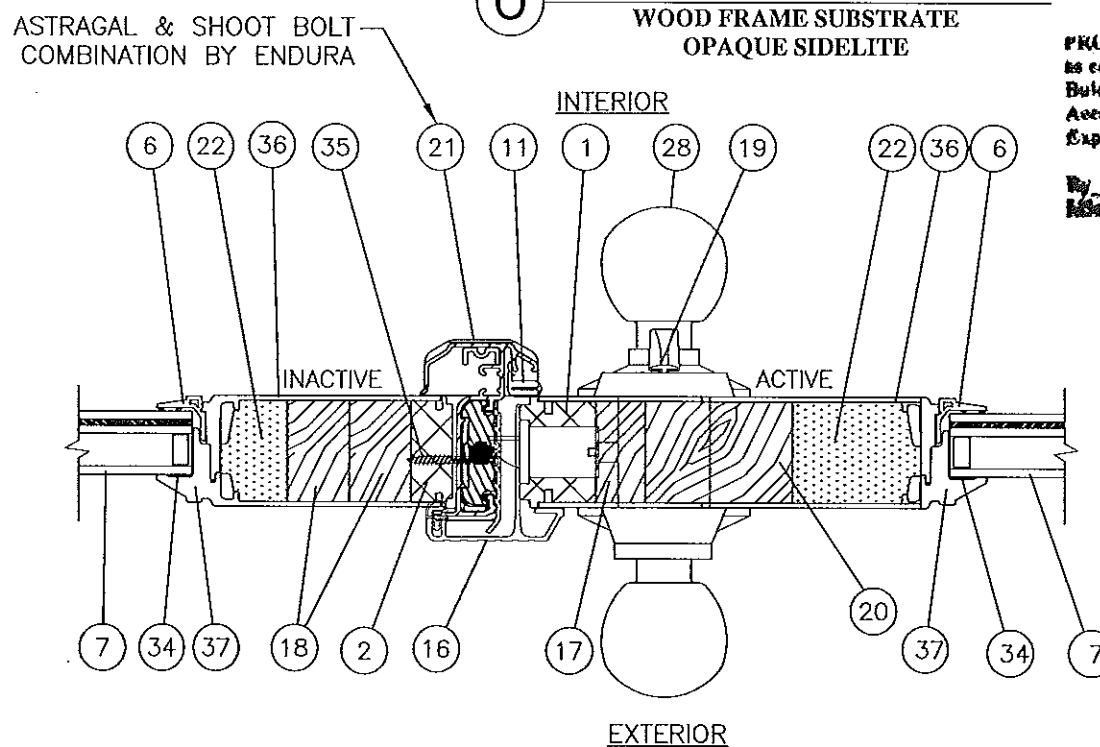


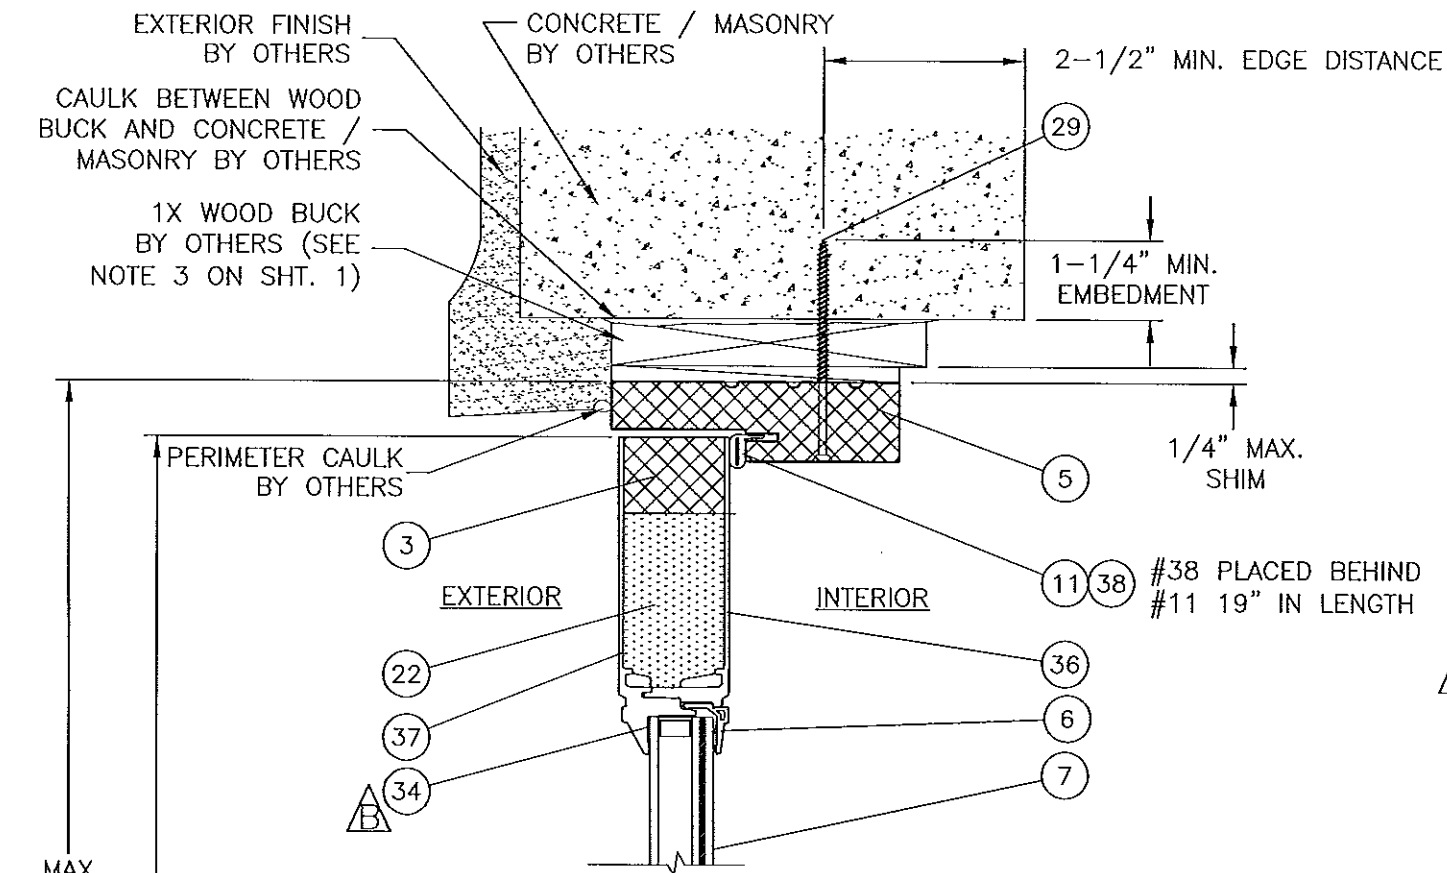
HORIZONTAL SECTION
ASTRAGAL
DOOR PANEL (A) / DOOR PANEL (A)

PRODUCT REVISED
to comply with the Florida
Building Code
Acceptance No. 14-0305-04
Expiration Date 3/1/17
By Gregory L. Gregory
Grand Duct Product Control


Robert J. Amoruso, P.E.
FL P.E. No. 49752

11/26/14

NAN YA PLASTICS CORP. 8989 NORTH LOOP EAST HOUSTON, TX 77029		PROJECT NO. 414-0107	
DISTINCTION DOUBLE IMPACT ENTRY O.S. DOOR W/ SIDELITES VERTICAL & HORIZONTAL SECTIONS			
PREPARED BY:	DRAWN BY:	DATE: 04/21/08	D NOA RENEWAL 02/26/14 RJJA
	SCALE: N.T.S.	DRAWING NO: NAN0011	C UPDATE TO 2010 FBC 04/25/12 TJH
PDC PRODUCT DESIGN GROUP, LLC PO BOX 520775 LONGWOOD, FLORIDA 32752 PHF C.A. NO. 75035	REV: D	SHEET: 5 OF 10	B PER MIAMI DADE 01/06/09 SMC
Phone: 321.860.1788 Fax: 321.860.1789 Email: info@pdc-corp.com	REV	DESCRIPTION	BY DATE




T VERTICAL SECTION
CONCRETE / MASONRY SUBSTRATE
DOOR PANEL (A)

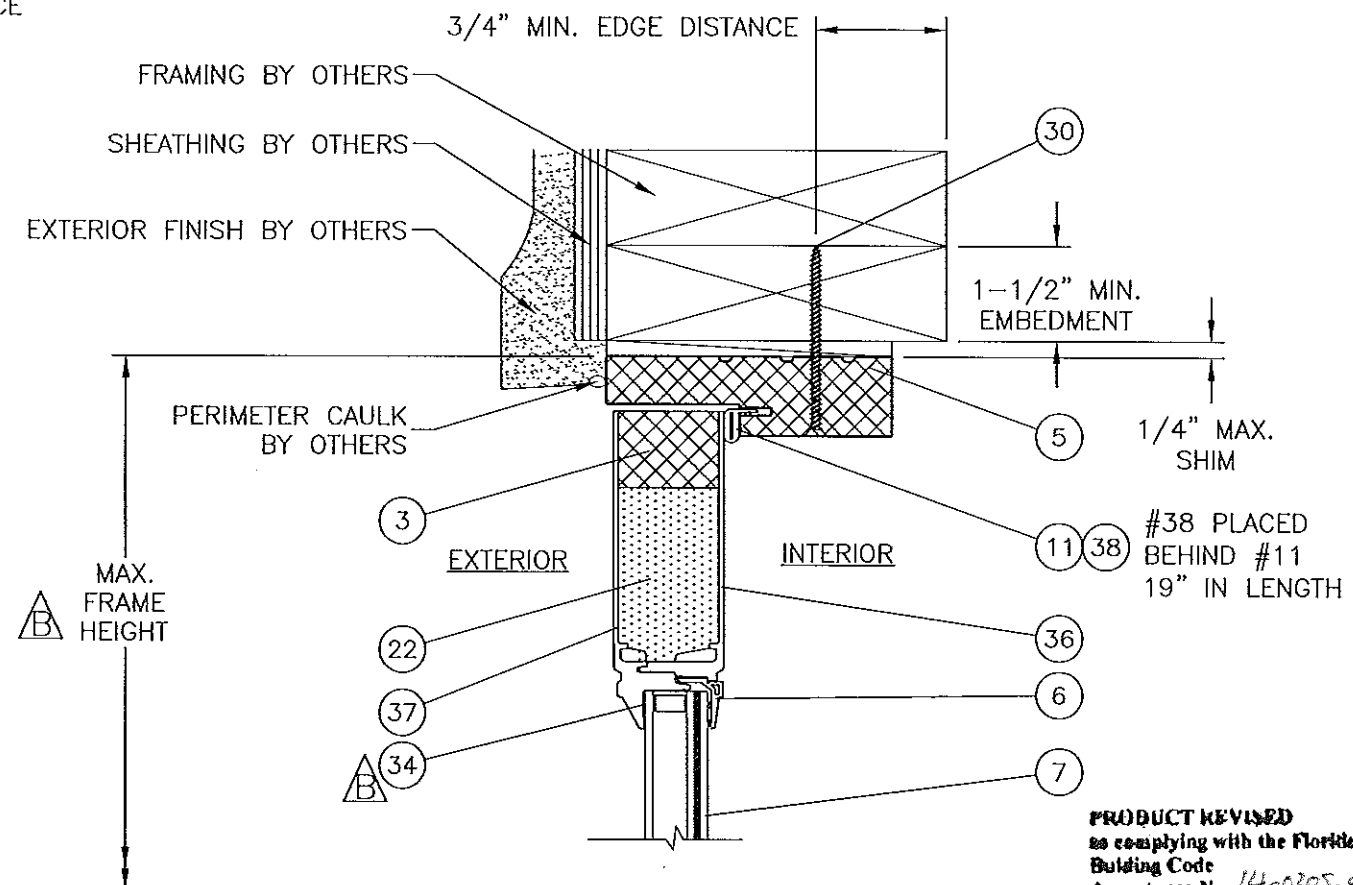


U VERTICAL SECTION
WOOD FRAME SUBSTRATE
DOOR PANEL (A)

PRODUCT REVISED
to comply with the Florida
Building Code
Acceptance No. 14-0305-04
Expiration Date 3/4/19
By *Cheng L. Kanda*
Miami Dade Product Control

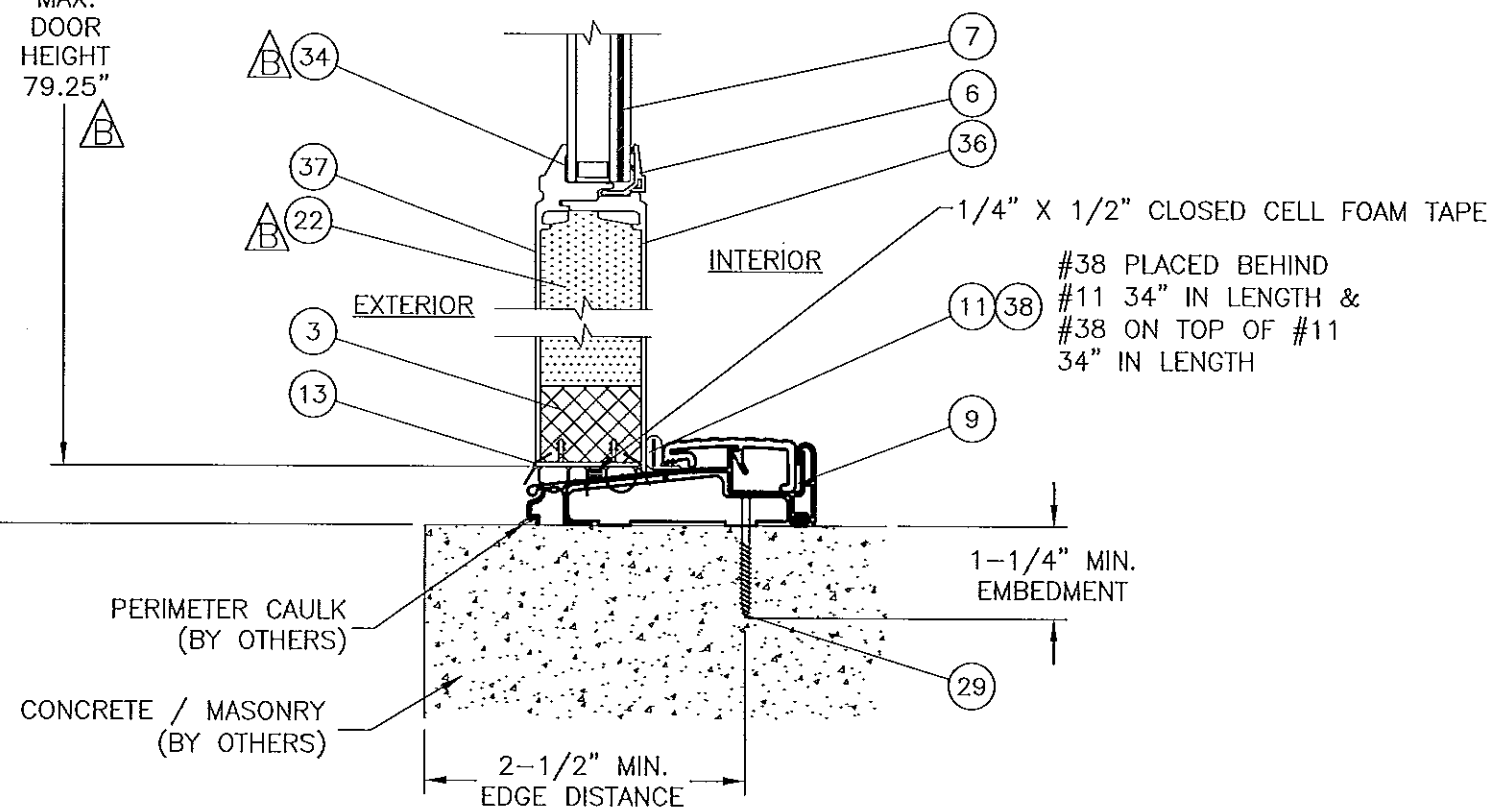

S VERTICAL SECTION
CONCRETE / MASONRY SUBSTRATE
DOOR PANEL (A)

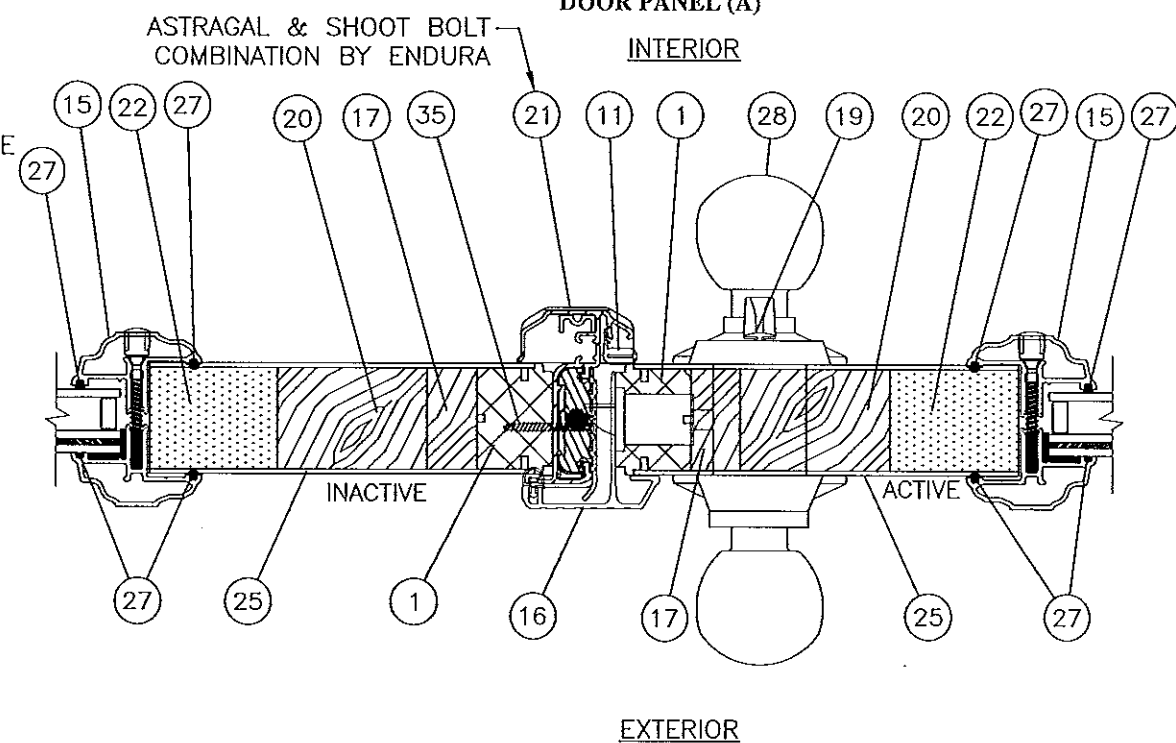






J HORIZONTAL SECTION
ASTRAGAL
DOOR PANEL (B) / DOOR PANEL (B)

PROJECT NO. 414-0107	NOA RENEWAL	UPDATE TO 2010 FBC	PER MIAMI DADE	DESCRIPTION
D	C	B	REV	DATE
02/26/14	04/25/12	1/15/09	DATE	BY
RJA	TJH	SMC	DATE	BY

NAN YA PLASTICS CORP. 8989 NORTH LOOP EAST HOUSTON, TX 77029	DATE: 04/21/08	DRAWING NO: NAN0011	SHEET: 6 OF 10
PREPARED BY: DISTINCTION DOUBLE IMPACT ENTRY O.S. DOOR W/ SIDELITES VERTICAL & HORIZONTAL SECTIONS	SCALE: N.T.S.	REV: D	
PTC PRODUCT DESIGN GROUP, LLC PO BOX 150775 LONGWOOD, FL 32715 FAX: 321.860.1788 E-MAIL: info@ptc-corp.com			

Robert J. Amoroso, P.E.
FL P.E. No. 49752

Wpd 2/26/14

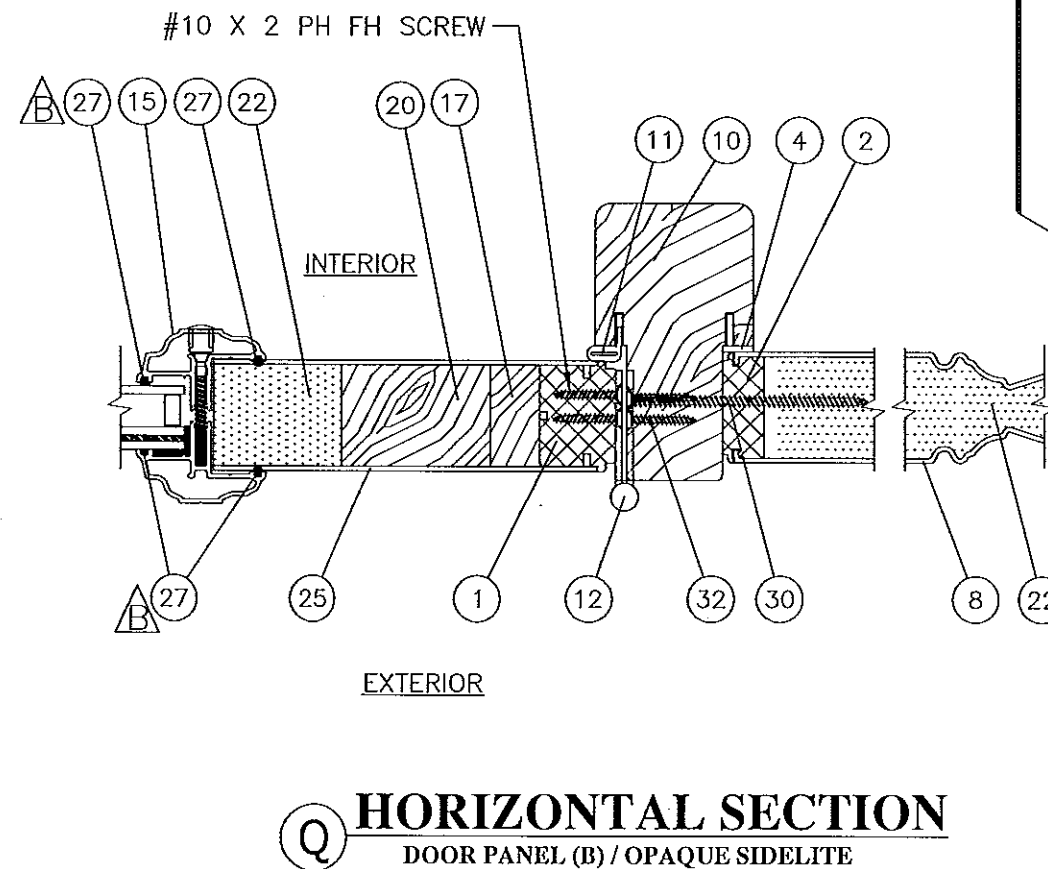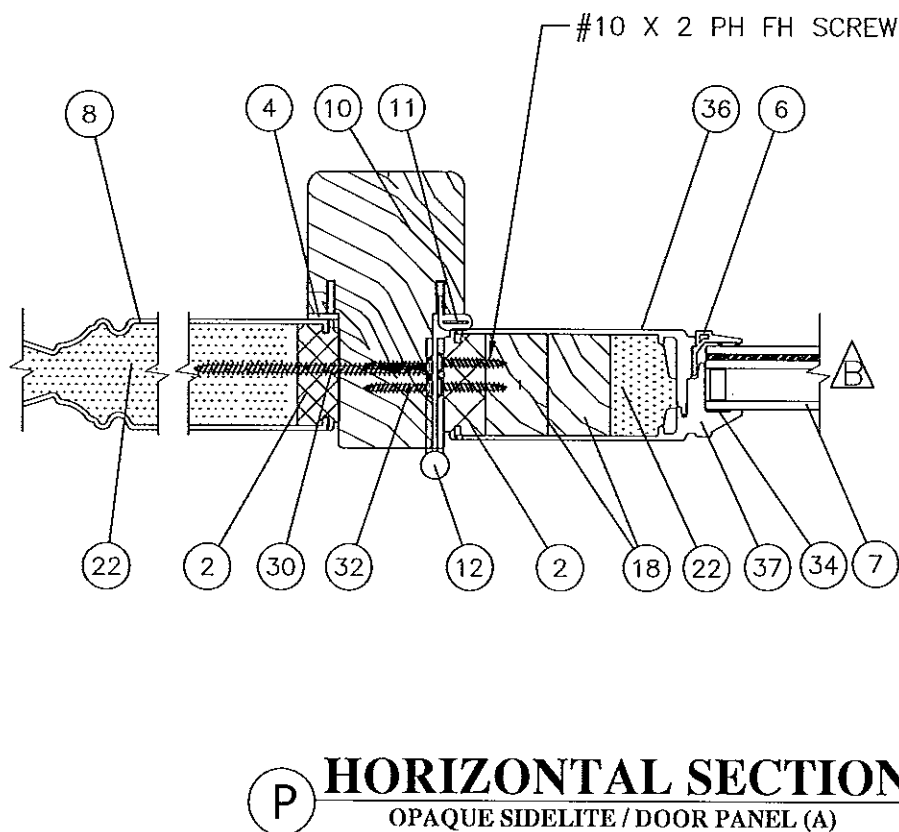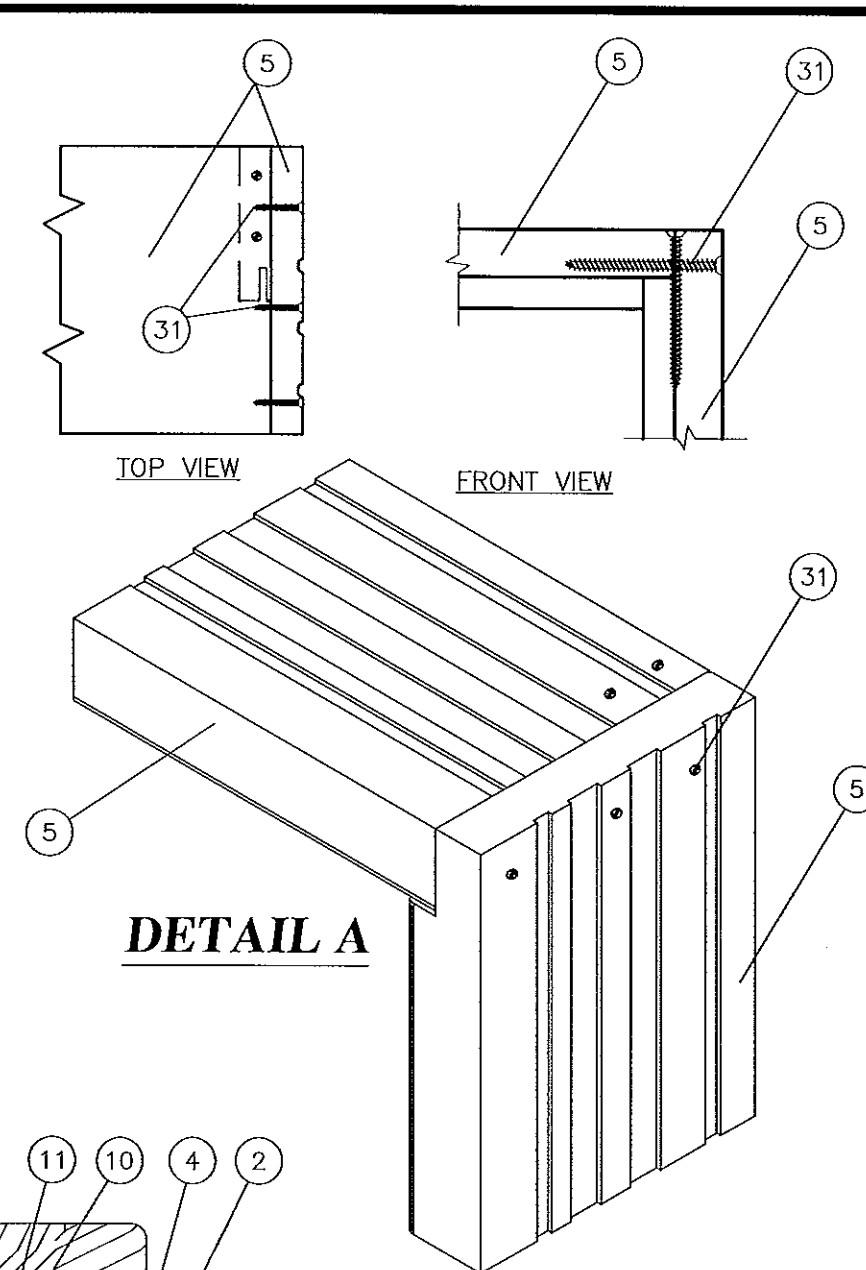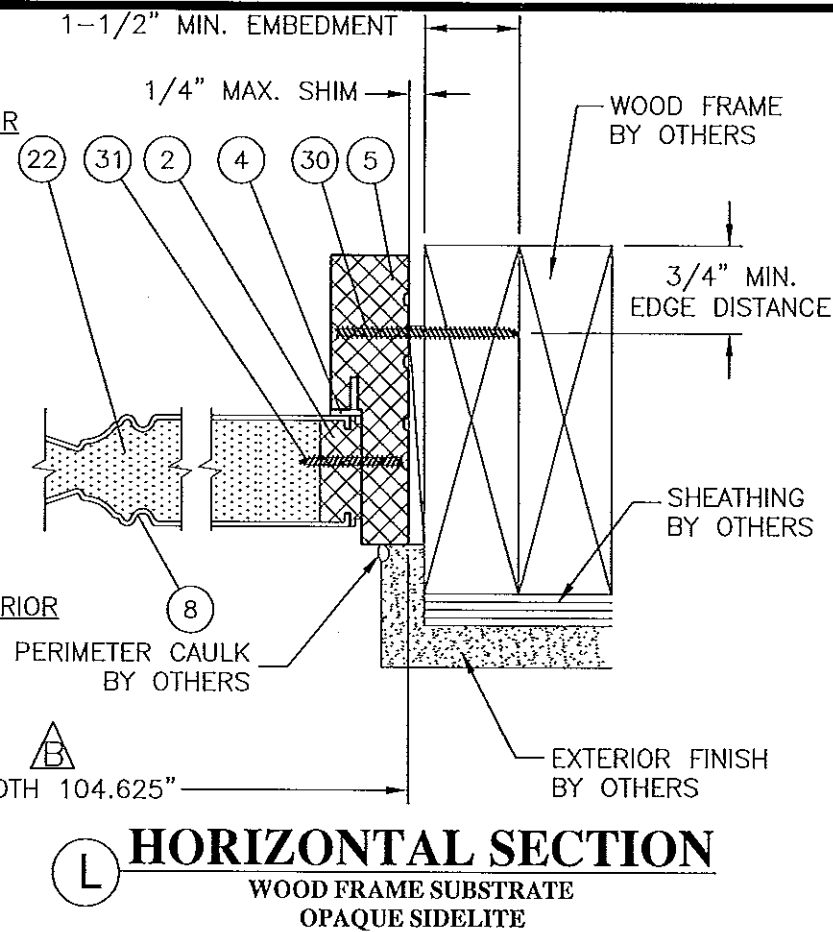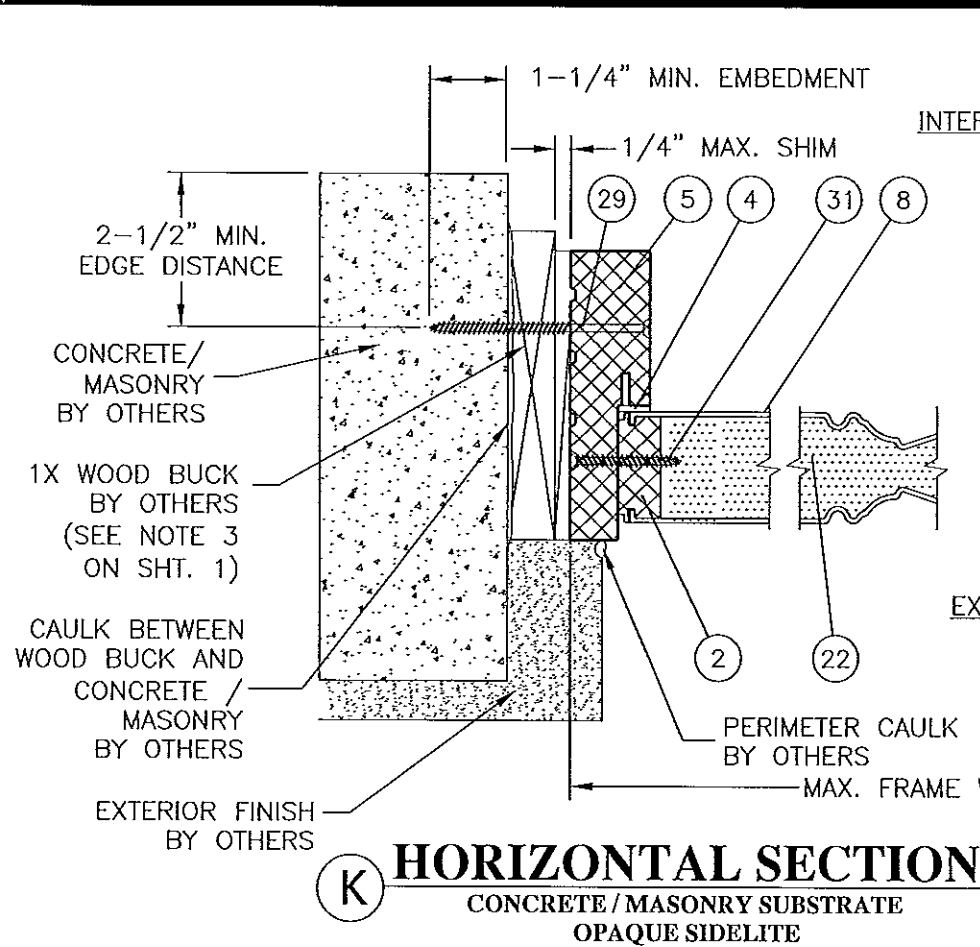


PRODUCT REVISED
to comply with the Florida
Building Code
Acceptance No. 14-0305-C4
Expiration Date 3/14/19
By [Signature]
Miami Dade Product Control


PROJECT NO. 414-0107		NOA RENEWAL		UPDATE TO 2010 FBC		PER MIAMI DADE		REV	
D	C	B	REV	DATE	DESCRIPTION	1/15/09	SMC	DATE	BY
RJA		TJH		SMC		BY			
02/26/14		04/25/12		1/15/09					
DISTINCTION DOUBLE IMPACT ENTRY O.S. DOOR W/ SIDELITES		HORIZONTAL SECTIONS & CORNER DETAILS		DRAWN BY: DATE: 04/21/08		DRAWING NO: NAN0011		SHEET: 8 OF 10	
NAN YA PLASTICS CORP.		8989 NORTH LOOP EAST		HOUSTON, TX 77029		SCALE: N.T.S.		REV: D	
PREPARED BY:		PTC PRODUCT DESIGN GROUP, LLC		PO BOX 52075		LONGWOOD, FLORIDA 32752		Email: info@ptc-corp.com	
Phone: 321.660.1788		Fax: 321.660.1789		FRRP C.A. NO. 21505					
Robert J. Amoroso, P.E.		FL P.E. No. 49752		1/15/09					

BILL OF MATERIALS					
ITEM NO.	PART NO.	QUANTITY	DESCRIPTION	MATERIAL	VENDOR
1	XXX	3	1 5/32" STILE	FOAM PVC	NANYA PLASTICS
2	XXX	8	5/8" STILE	FOAM PVC	NANYA PLASTICS
3	XXX	1	1 3/4" TOP/BOTTOM RAIL INSERT	FOAM PVC	NANYA PLASTICS
4	XXX	AS REQ'D.	SILICONE SEALANT	-----	-----
5	XXX	3	FRAME HEAD & JAMB	FOAM PVC	NANYA PLASTICS
6	XXX	AS REQ'D.	1" GLAZING BEAD	RIGID PVC	NANYA PLASTICS
7	XXX	-----	1/8" TEMPERED GLASS, 0.540" AIR SPACE (A1-S SPACER, 1/8" ANNEALED GLASS, 0.090" PVB INTERLAYER BY SOLUTIA, 1/8" ANNEALED GLASS	-----	CARDINAL
8	XXX	-----	SMC 00S OPAQUE SIDELITE SKIN (Fy MIN. = 11,000 PSI) A	FIBERGLASS SKIN A	NAN YA PLASTICS A
9	XXX	3	SILL ASSY.	ALUMINUM	ENDURA
10	XXX	2	MULLION	PINE WOOD & FLOUR	ENDURA
11	XXX	AS REQ'D.	Q-LON 650 WEATHERSTRIPPING	FOAM SILICONE PE FILM	Q-LON
12	-----	4	4" X 4" HINGE	STEEL	MICOTA
13	XXX	2	DOOR SWEEP	RIGID PVC CO-EX	ENDURA
14	XXX	2	CORNER PAD	FOAM SILICONE PE FILM	DOW-TECH PLASTICS
15	XXX	AS REQ'D.	ODL HURRICANE IMPACT LIGHT FRAME SYSTEM (PER CURRENT NOA) A	ALUMINUM	ODL
16	XXX	2	OUTSWING PANEL TRIM	ALUMINUM, PVC	ENDURA
17	XXX	2	REINFORCEMENT 25/32" X 1 19/32"	WHITE PINE	-----
18	XXX	2	REINFORCEMENT 31/32" X 1 19/32"	WHITE PINE	-----
19	XXX	1	DEAD BOLT--KEYED	-----	KWIK--SET
20	XXX	2	REINFORCEMENT 2 11/32" X 1 19/32" A	WHITE PINE	-----
21	XXX	1	HURRICANE ASTRAGAL WITH SHOOT BOLT A	ALUMINUM, STEEL, PVC	ENDURA
22	XXX	AS REQ'D.	PHENOLIC FOAM	-----	NANYA PLASTICS
23	XXX	2	SMC S12P (M) SIDELITE SKIN (Fy MIN. = 11,000 PSI) A	FIBERGLASS SKIN	NANYA PLASTICS A
24	XXX	2	SMC S14P (F) SIDELITE SKIN (Fy MIN. = 11,000 PSI) A	FIBERGLASS SKIN	NANYA PLASTICS A
25	XXX	2	SMC OOP DOOR SKIN (Fy MIN. = 11,000 PSI) A	FIBERGLASS SKIN	NANYA PLASTICS A
26	XXX	1	SIDELIGHT BASE SUPPORT	-----	-----
27	XXX	1	REDI-SEAL GLAZING COMPOUND BY ODL A	SILICONE A	ODL A
28	XXX	1	DOOR KEYED ENTRY LATCH SET	-----	KWIK-SET
29	-----	-----	1/4" ITW TAPCON W/ 1-1/4" MIN. EMBEDMENT	STEEL	ITW A
30	-----	12	#12 X 3" PH FL HD SCREW	STEEL	-----
31	-----	14	#10 X 2 1/2" PH LF HD SCREW	STEEL	-----
32	-----	12	#10 X 1 1/2" PH FL HD SCREW	STEEL	-----
33	-----	14	#10 X 1" PH FL HD SCREW	STEEL	-----
34	-----	-----	DOW CORNING 995 SILICONE SEALANT	SILICONE	DOW CORNING
35	-----	-----	#8 X 1" PH FL HD SCREW	-----	-----
36	XXX	2	SMC 14P (M) DOOR SKIN (Fy MIN. = 11,000 PSI) A	FIBERGLASS SKIN	NAN YA PLASTICS
37	XXX	2	SMC 12P (F) DOOR SKIN (Fy MIN. = 11,000 PSI) A	FIBERGLASS SKIN	NAN YA PLASTICS
37	XXX	-----	1/4" DIA. HOLLOW BULB SEAL -- ADHESIVE BACKED A	-----	-----

PRODUCT REVIEWED
 no complying with the Florida
 Building Code
 Acceptance No. 14-0365.04
 Expiration Date 3/19/19
 By Shang L. Chan
 Miami Dade Product Control

PROJECT NO. 414-0107		NOA RENEWAL		UPDATE TO 2010 FBC		PER MIAMI DADE 01/06/09	
D		C		B		REV	
02/26/14		04/25/12		1/15/09		DATE	
RJA		TJH		SMC		BY	

NAN YA PLASTICS CORP. 8989 NORTH LOOP EAST HOUSTON, TX 77029		DISTINCTION DOUBLE IMPACT ENTRY O.S. DOOR W/ SIDELITES BILL OF MATERIALS		DATE: 04/21/08		DRAWING NO: NAN0011	
PREPARED BY:		SCALE: N.T.S.		SHEET: 9 OF 10		REV: D	
 PTC PRODUCT DESIGN GROUP, LLC PO BOX 520775 LONGWOOD, FLORIDA 32752 Phone: 321.860.1788 Fax: 321.860.1768 Email: info@ptc-corp.com							

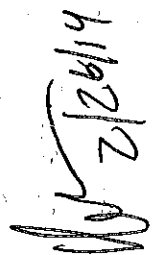Robert J. Amoroso, P.E. FL P.E. No. 49752	 4/19/2014
--	--

